IREDELL COUNTY HEALTH DEPARTMENT

STATESVILLE 704-878-5305 MOORESVILLE 704-664-5281

IMPROVEMENT PERMIT / AUTHORIZATION TO CONSTRUCT / OPERATION PERMIT / EXISTING SYSTEM INSPECTION

3150 Paid 3:00

PERMIT# 072831 PIN# ~~4625941684~~ 4635-13-0987 Brian DATE 7/19/2002

OWNER OR CONTRACTOR Simonini Builders PHONE: Business (704) 309-3253 Home

ADDRESS 817 E. Morehead St. Ste. 100 Charlotte, NC 28202 156 Old Post

LOCATION Brawley School Rd TL the Pointe Dr. TL Meeting House TL Easton Dr to Old Post Rd on Right

SUBDIVISION The Pointe BLOCK / SECTION A LOT 16 LOT AREA .76 Acre SITE CLASS. PS DESIGN FLOW 600gpd L.T.A.R. .25

Septic Tank: 1500 Gallons; STB 338 Date 9/18/02

Pump Tank: 1500 Gallons; PT 338 Date 8/30/02

Pump Make: Model Serial No.

Nitrification Field: No Fields 1 Square Feet 1200' Linear Feet 400'

No Lines 4@100' Trench Width 24"-36" Max Trench Bottom Depth 30" Gravel Depth N/A

☒ New System ☐ Repair System Type: I, II, III, IV, V, VI

System Description: pump-PM-Panel Blk

Repair System Description: Same

Maintenance Agreement Required: ☒ Yes ☐ No

☒ House/Mod. Home No. Bedrooms 5

☐ Mobile Home No. Bathrooms 4

☐ Business No. Employees

☐ Other

☐ Slab ☒ Crawl Space ☐ Basement w/plumbing ☐ Basement wo/plumbing


Water Supply: ☐ Individual ☒ Public ☒ Community

Comments:/Conditions: Remove old berms & terraces. Keep Septic System at least 10' from PL. Do Not exceed 100' with drainlines


Comments:/Conditions:

Hole drilled at = 3/16"
Checked lines 11/21/2002
Pressure, electrical & alarm 1/22/2003

Scale 1:50 INITIAL SITE SKETCH

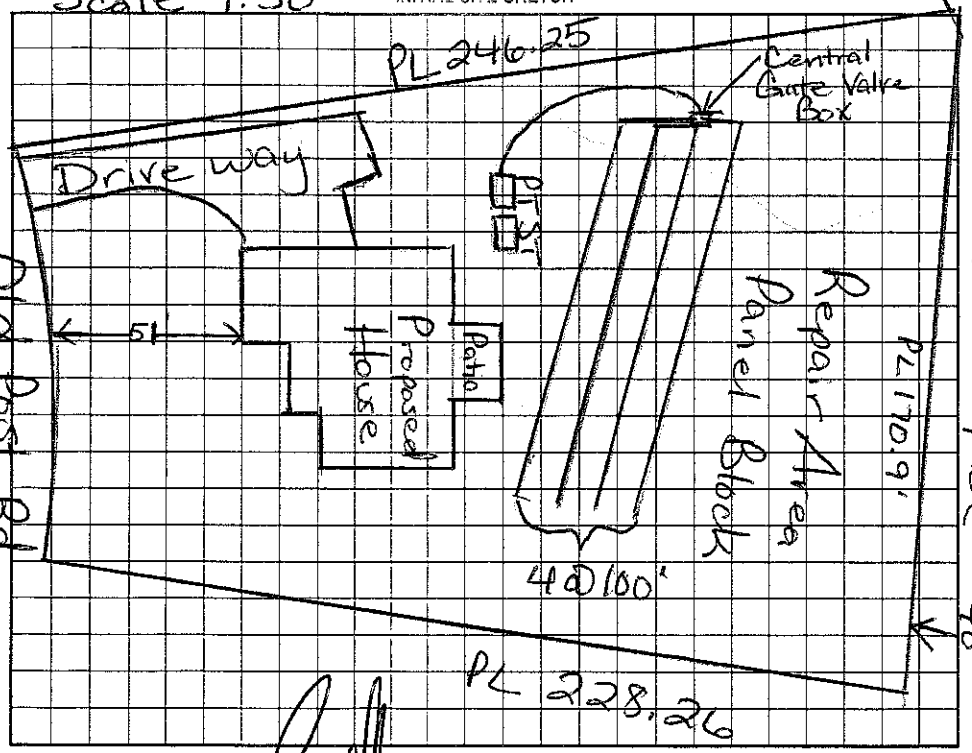

AS BUILT SKETCH

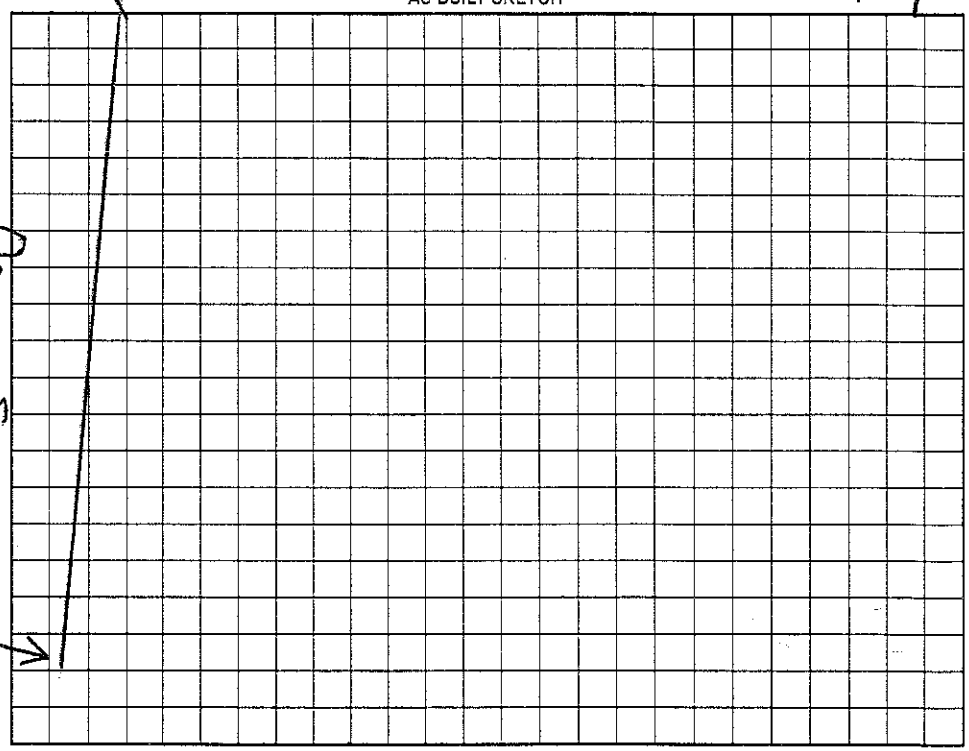

Permit can be suspended or revoked if any false information is supplied toward securing the permit/any unauthorized changes are made to the site/any unauthorized changes are made in the installation of the system. Improvement Permit with plat valid without expiration. Improvement Permit with site plan valid for sixty months. Authorization to Construct is valid for a period equal to that of Improvement Permit – not to exceed sixty months.

Signed: date 7/24/02 Installed by: R & H

Improvement Permit by: Maria H. Dotson RS date 7/22/2002 Operation Permit by: Maria H. Dotson RS date 1/22/03

Authorization to Construct by: Maria H. Dotson RS date 7/22/2002 Existing System Inspection by: date

HEALTH DEPT. COPY: WHITE OWNER COPY (FINAL): YELLOW OWNER COPY (INITIAL): PINK