IREDELL COUNTY HEALTH DEPARTMENT

STATESVILLE 704-878-5305 MOORESVILLE 704-664-5281

IMPROVEMENT PERMIT / AUTHORIZATION TO CONSTRUCT / OPERATION PERMIT / EXISTING SYSTEM INSPECTION

3130-4!

PERMIT# 072842 PIN# 4625944684 4635-15-2097 DATE July 30, '98

OWNER OR CONTRACTOR Crescent Resources dba/Hughes & Assoc PHONE: Business (704) 542-6816 Home

ADDRESS PO Box 1003, Charlotte

LOCATION Brawley Sch. Rd TL the Pointe Dr. Queen Anne Circle to Vineyard DRIVE to Falmouth Rd. on left @ jct w/ ESSEX Ct.

SUBDIVISION The Pointe BLOCK / SECTION 1A LOT 36 LOT AREA 37189 ft² SITE CLASS. PS DESIGN FLOW 400gpd L.T.A.R. 03

Septic Tank: ~~1000~~ 1500 Gallons; STB 338 Date 7-11-03

Pump Tank: ~~1500~~ Gallons; PT Date

Pump Make: Model Serial No.

Nitrification Field: No. Fields 1 Square Feet 1200 Linear Feet 400

No. Lines 5@80' Trench Width 36" Max Trench Bottom Depth 36" Gravel Depth NA

☑ New System ☐ Repair System Type: I, II, III, IV, V, VI

System Description: GRAVITY 25% Reduction

Repair System Description: GRAV/Pumped 25-50% Red.

Maintenance Agreement Required: ☐ Yes ☑ No initially

☑ House/Mod. Home ☐ Mobile Home ☐ Business ☐ Other

No. Bedrooms 4 No. Bathrooms 4 No. Employees


☐ Slab ☑ Crawl Space ☐ Basement w/plumbing ☐ Basement wo/plumbing

Water Supply: ☐ Individual ~~☑ Public~~ ~~☑ Community~~


Comments:/Conditions: ~~HOUSE INSpection to be submitted~~ part per Lateral. Remove any old Berms/Terraces

Comments:/Conditions: Reviewed plans 1/31/03 essentially in Compliance with original permit. Lines checked 8/15/03

INITIAL SITE SKETCH

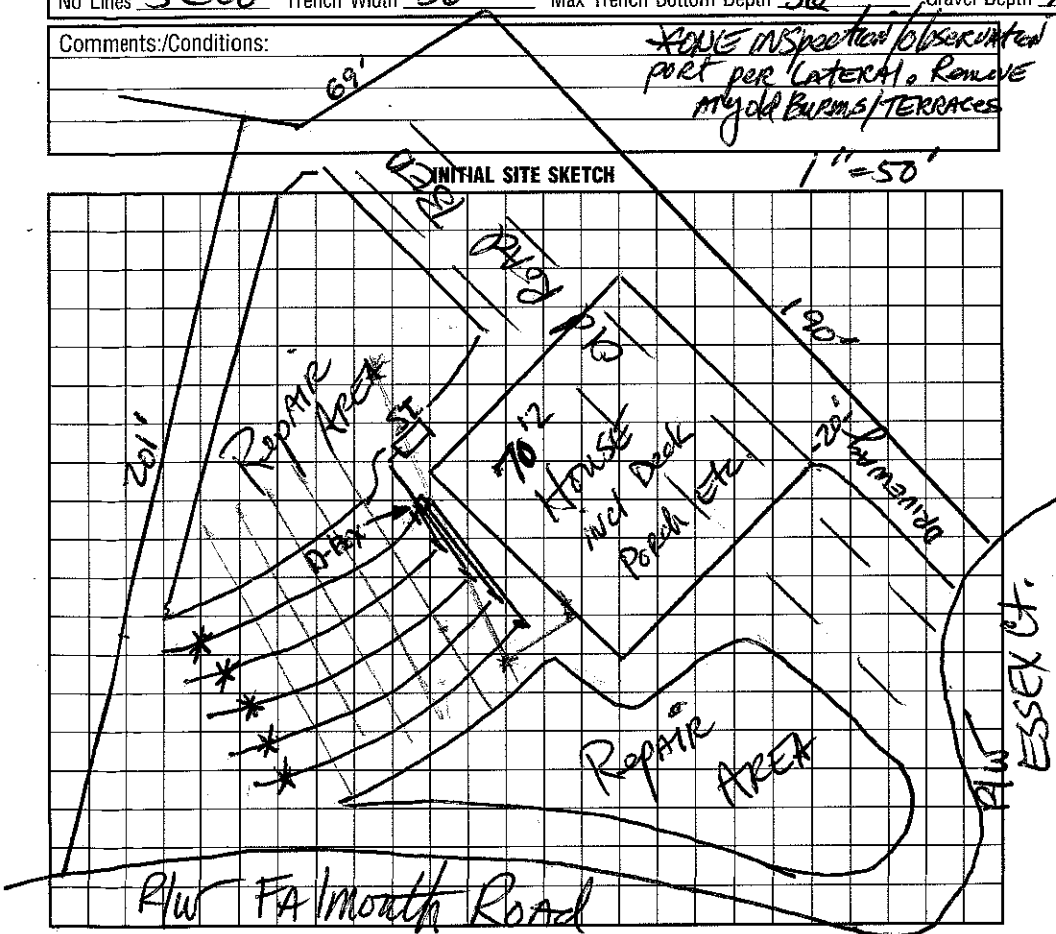

AS BUILT SKETCH

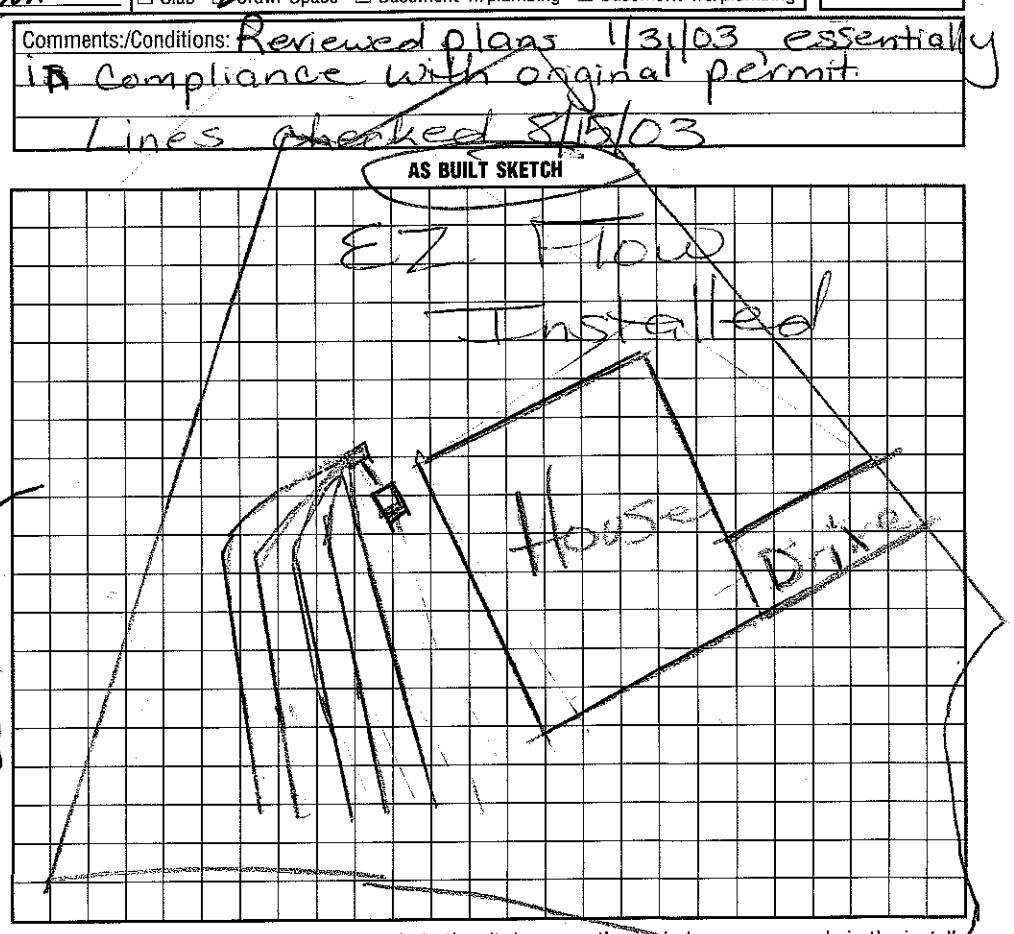

I understand that this permit can be suspended or revoked if any false information is supplied toward securing the permit/any unauthorized changes are made to the site/any unauthorized changes are made in the installation of the system. Improvement Permit with plat valid without expiration. Improvement Permit with site plan valid for sixty months. Authorization to Construct is valid for a period equal to that of Improvement Permit – not to exceed sixty months.

Signed: Randy Ross date 8-20-98 Installed by: R&H RS

Improvement Permit by: Mark Eatman RS date 7-30-98 Operation Permit by: Marvin Dixon RS date 8/18/03

Authorization to Construct by: Marvin Dixon RS date 1/31/03 Existing System Inspection by: date

HEALTH DEPT. COPY: WHITE INSPECTION COPY (FINAL): GREEN OWNER COPY (FINAL): YELLOW INSPECTION COPY (INITIAL): PINK OWNER COPY (INITIAL): GOLD