IREDELL COUNTY HEALTH DEPARTMENT

STATESVILLE 704-878-5305 MOORESVILLE 704-664-5281

IMPROVEMENT PERMIT / AUTHORIZATION TO CONSTRUCT / OPERATION PERMIT / EXISTING SYSTEM INSPECTION

PERMIT# 0721 27 PIN# 4625 94 1684 4635-13-5347 DATE 11/4/99

OWNER OR CONTRACTOR Potter Builders Inc. PHONE: Business _____ Home _____

ADDRESS _____

LOCATION 1100 TL Pointe Dr. TL Meeting House TL Euston TR Old Post Rd. to corner of Falmouth and Barnstable Ct.

SUBDIVISION POINTE BLOCK / SECTION 1A LOT 26 LOT AREA 1AC SITE CLASS PS DESIGN FLOW 600 L.T.A.R. .3

Septic Tank: 1500 Gallons; STB 797 Date 8/99

Pump Tank: _____ Gallons; PT _____ Date _____

Pump Make: _____ Model _____ Serial No. _____

Nitrification Field: No Fields 1 Square Feet 1479 Linear Feet 499

No Lines 6 Trench Width 36" Max Trench Bottom Depth 36" ~~Gravel Depth~~ SAND

☒ New System ☐ Repair System Type: I, II, (III) IV, V, VI

System Description: CULPLAS or NDS - GRAVITY

Repair System Description: Pressure

Maintenance Agreement Required: ☒ Yes ☐ No

☒ House/Mod. Home No. Bedrooms 5

☐ Mobile Home No. Bathrooms 4

☐ Business No. Employees _____

☐ Other _____

☐ Slab ☒ Crawl Space ☐ Basement w/plumbing ☐ Basement wo/plumbing


Water Supply: ☐ Individual ☐ Public ☒ Community

Comments:/Conditions:

INITIAL SITE SKETCH

Comments:/Conditions:

AS BUILT SKETCH

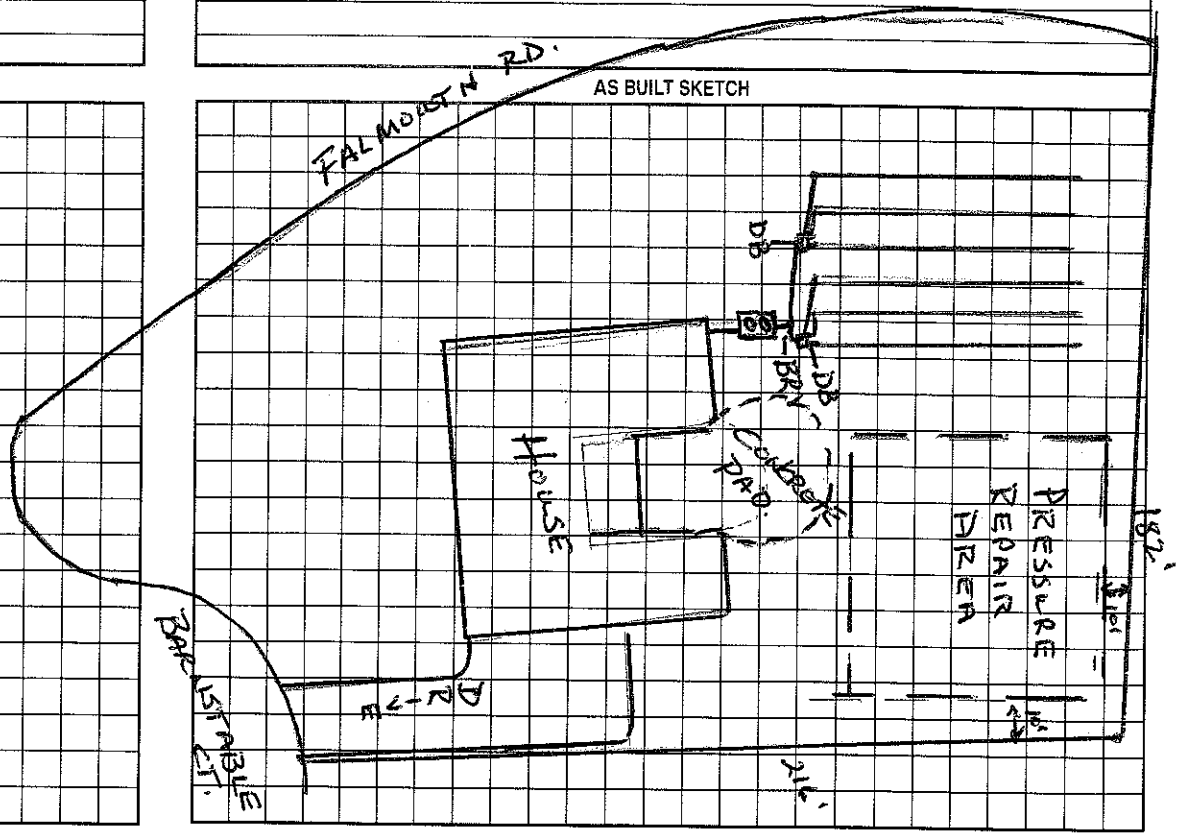

Permit can be suspended or revoked if any false information is supplied toward securing the permit/any unauthorized changes are made to the site/any unauthorized changes are made in the installation of the system. Improvement Permit with plat valid without expiration. Improvement Permit with site plan valid for sixty months. Authorization to Construct is valid for a period equal to that of Improvement Permit – not to exceed sixty months.

Signed: _____ date _____

Improvement Permit by: _____ date _____

Authorization to Construct by: _____ date _____

Installed by: Bob Mayhew

Operation Permit by: Wesley Sparks R.S. date 11/4/99

Existing System Inspection by: _____ date _____

HEALTH DEPT. COPY: WHITE OWNER COPY (FINAL): YELLOW OWNER COPY (INITIAL): PINK