IREDELL COUNTY HEALTH DEPARTMENT

STATESVILLE 704-878 5305 280.00 Paid MOORESVILLE 704-664-5281

IMPROVEMENT PERMIT / AUTHORIZATION TO CONSTRUCT / OPERATION PERMIT / EXISTING SYSTEM INSPECTION

PERMIT# 130619 PIN# 4635137149 DATE 9-12-05

OWNER OR CONTRACTOR Elizabeth Molloy PHONE: Business Home 799-6941

ADDRESS 108 Barnstable, Mooresville, NC

LOCATION Brawley School Rd TR Meeting House to Easton Dr to Old Post to Falmouth to Barnstable

SUBDIVISION The Point BLOCK / SECTION 1A LOT 24 LOT AREA 44615 SITE CLASS. PS DESIGN FLOW 480 L.T.A.R. .3

Existing / Addition

Septic Tank: 1500 Gallons; STB Date

Pump Tank: 1000 Gallons; PT Date

Pump Make: Model Serial No. Total

Nitrification Field: No Fields 1 Square Feet 1200 Linear Feet 400

No Lines 1 @ 135' Trench Width 36" Max Trench Bottom Depth 36" Gravel Depth N/A

☐ New System ☐ Repair System Type: I, II, III, IV, V, VI

System Description: Pump - 25% Reduction

Repair System Description: Pump - Panel BIK

Maintenance Agreement Required: ☐ Yes ☒ No

☒ House/Mod. Home ☐ Mobile Home ☐ Business ☐ Other

No. Bedrooms 4 No. Bathrooms No. Employees


☐ Slab ☒ Crawl Space ☐ Basement w/plumbing ☐ Basement wo/plumbing

Water Supply: ☐ Individual ☒ Public ☒ Community

Comments:/Conditions:

Install Flow Divider & split flow between 2 Existing lines (Remove Drainfield within 15' of Pool Cut)

INITIAL SITE SKETCH

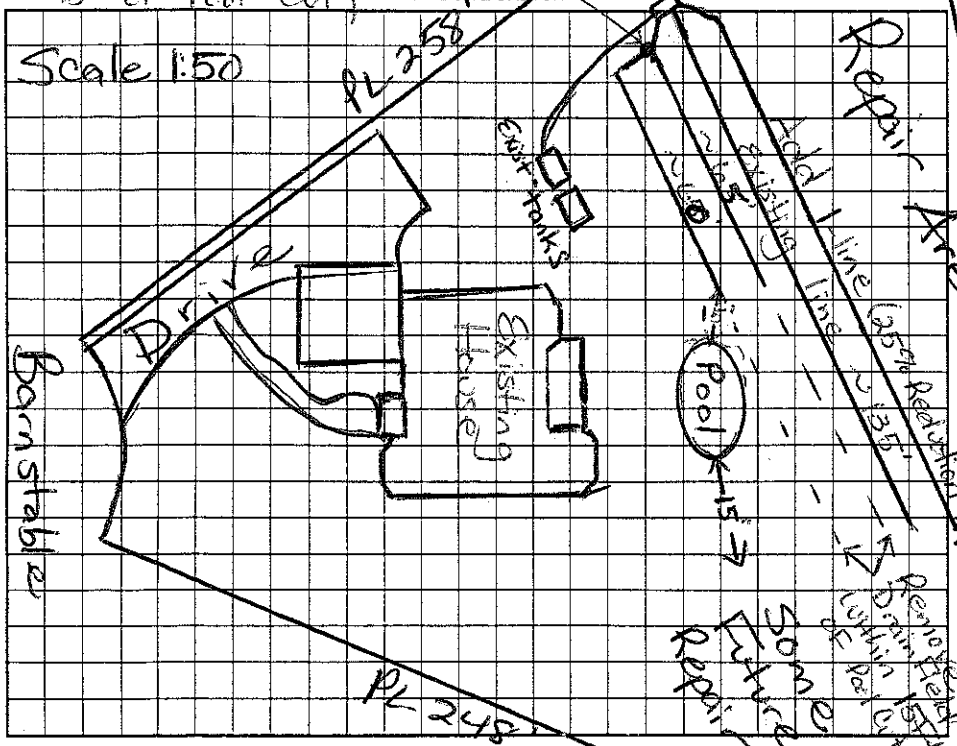

Comments:/Conditions: ★ Pool cut must be 15' from Septic System

drafted as drawn - Howard

AS BUILT SKETCH

Permit can be suspended or revoked if any false information is supplied toward securing the permit/any unauthorized changes are made to the site/any unauthorized changes are made in the installation of the system. Improvement Permit with plat valid without expiration. Improvement Permit with site plan valid for sixty months. Authorization to Construct is valid for a period equal to that of Improvement Permit – not to exceed sixty months.

Signed: Elizabeth Molloy 9-21-05 date Installed by: R+H

Improvement Permit by: Maria H. Colon RS date 9/12/05 Operation Permit by: Wesley Sparks RS date 3/31/06

Authorization to Construct by: Maria H. Colon RS date 9/12/05 Existing System Inspection by: date

HEALTH DEPT. COPY: WHITE OWNER COPY (FINAL): YELLOW OWNER COPY (INITIAL): PINK