3:00

IREDELL COUNTY HEALTH DEPARTMENT

STATESVILLE 704-878-5305 MOORESVILLE 704-664-5281

IMPROVEMENT PERMIT / AUTHORIZATION TO CONSTRUCT / OPERATION PERMIT / EXISTING SYSTEM INSPECTION

PERMIT# 07125 PIN# 4625941684 4635 13 7149 DATE Dec. 3, '99

OWNER OR CONTRACTOR Crescent Resources Usa // Guardian Homes PHONE: Business Home

ADDRESS P.O. Box 1103, Charlotte

LOCATION Brawley Sch Rd. Turn on the Point Dr. Meeting House Circle to Easton Drive to Old Post Rd to Falmouth to Barnstable

SUBDIVISION The Point BLOCK / SECTION 1A LOT 24 LOT AREA 44615 sf SITE CLASS. PS DESIGN FLOW 480 gpd L.T.A.R. .3

Septic Tank: 1500 Gallons; STB 338 Date 11/00
Pump Tank: 1000 Gallons; PT 27 Date 11/00
Pump Make: MYERS Model ME-3F Serial No.
Nitrification Field: No Fields 1 Square Feet 1200 sf Linear Feet 480 +
No Lines 3@134 Trench Width 36" Max Trench Bottom Depth 36" Gravel Depth NA.

☑ New System ☐ Repair System Type: I, II, III, IV, V, VI
System Description: pm - INNOVATIVE - 25% Red.
Repair System Description: SAME
Maintenance Agreement Required: ☐ Yes ☑ No

☑ House/Mod. Home ☐ Mobile Home ☐ Business ☐ Other
No. Bedrooms 4 No. Bathrooms 4 No. Employees


☐ Slab ☑ Crawl Space ☐ Basement w/plumbing ☐ Basement wo/plumbing

Water Supply: ☐ Individual ☑ Public ☑ Community

Comments:/Conditions:
Redraw - to Innovative field at builder request.
25% Red.

Comments:/Conditions: Drainlines checked 1/3/2000 mjd
Replaces previous permit issued 7/28/98

INITIAL SITE SKETCH

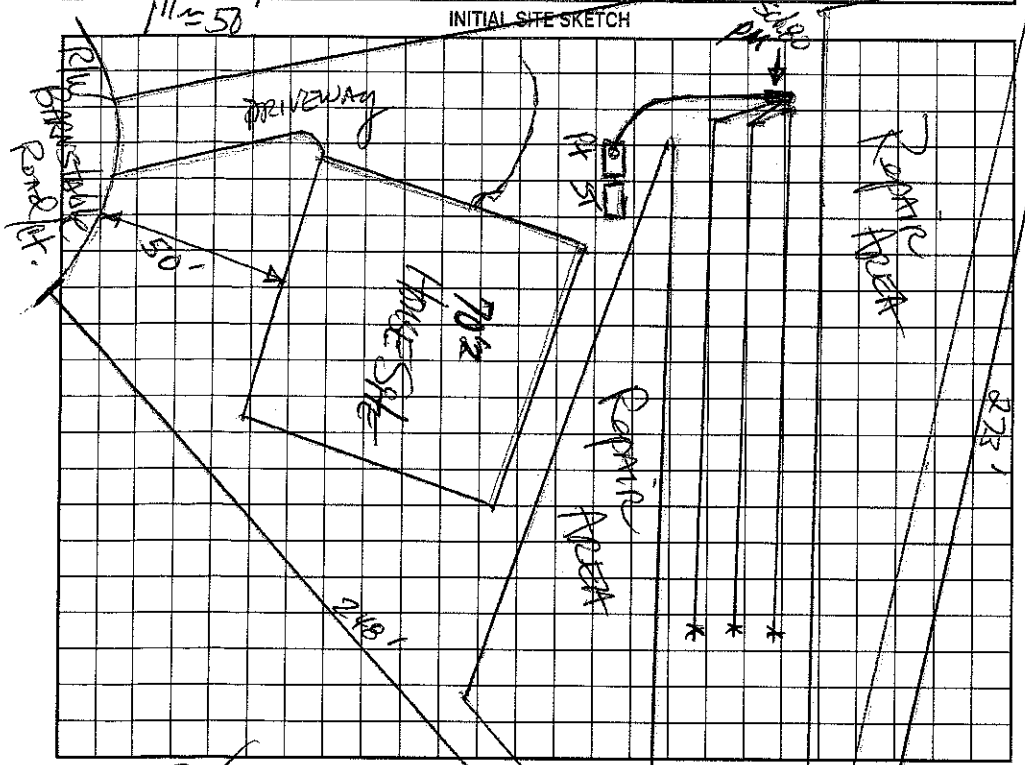

AS BUILT SKETCH

Drainfield installed as Drawn - EZ Lay System installed.

Permit can be suspended or revoked if any false information is supplied toward securing the permit/any unauthorized changes are made to the site/any unauthorized changes are made in the installation of the system. Improvement Permit with plat valid without expiration. Improvement Permit with site plan valid for sixty months. Authorization to Construct is valid for a period equal to that of Improvement Permit – not to exceed sixty months.

Signed: date 12-6-99 Installed by: R + H Inc.

Improvement Permit by: date 12-3-99 Operation Permit by: Wesley Sparks R.S. date 2/25/00

Authorization to Construct by: date 12-3-99 Existing System Inspection by: date

HEALTH DEPT. COPY: WHITE OWNER COPY (FINAL): YELLOW OWNER COPY (INITIAL): PINK