IREDELL COUNTY HEALTH DEPARTMENT

STATESVILLE 704-878-5305 MOORESVILLE 704-664-5281

IMPROVEMENT PERMIT / AUTHORIZATION TO CONSTRUCT / OPERATION PERMIT / EXISTING SYSTEM INSPECTION

2-2:30

PERMIT# 142181 PIN# 4635 13 7385 DATE 9/27/07

OWNER OR APPLICANT Kenneth Booker Hayes PHONE: Business 662-6400 Home

ADDRESS PO Box 3398 Mooresville NC 28117

LOCATION Bayntable Ct; 1100 TR Point Dr TL Misty Haven TL Easton TR Old Post TR Fairview Ln TR Bayntable Cove Left (R)

SUBDIVISION Point BLOCK / SECTION 1A LOT 23 LOT AREA .195 Ac SITE CLASS. PS DESIGN FLOW 600 L.T.A.R. .25

Septic Tank: 1500 Gallons; ST8 338 Date 2-18-08

Pump Tank: 1500 Gallons; PT 994 Date 3-21-08

Pump Make: Model Serial No.

Nitrification Field: No Fields 1 Square Feet 1200 Linear Feet 400

No Lines 5 X Trench Width 2-3' Max Trench Bottom Depth 30

☒ New System ☐ Repair ☐ Expansion System Type: I II III ⓘⓥ V VI

System Description: Pressure Dosed - 16" PPBPS

Repair System Description: Same Type

Maintenance Agreement Required: ☐ Yes ☐ No

☒ House/Mod. Home No. Bedrooms 5

☐ Mobile Home No. Persons

☐ Business No. Employees

☐ Other


Water Supply: ☐ Individual ☐ Public ☒ Community POINT

Gravel Depth No ☐ Gravity ☒ Pressure ☐ Slab ☒ Crawl Space ☐ Basement w/plumbing ☐ Basement wo/plumbing


Comments:/Conditions: See design sketch; 7/18/08 Tanks Checked

Comments:/Conditions: Lines 1-4 Checked 7/18/08 & bottom of trench on 5th line 7/21/08 5th line Complete 9/8/08 Pres, clear & alarm

INITIAL SITE SKETCH (1"=60')

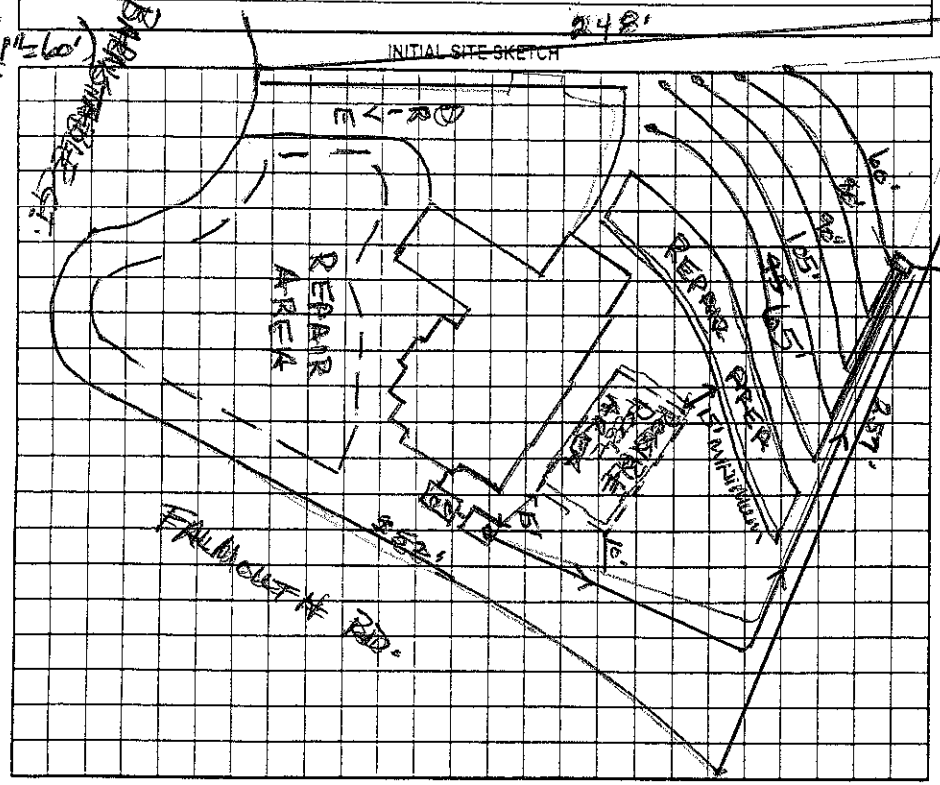

AS BUILT SKETCH

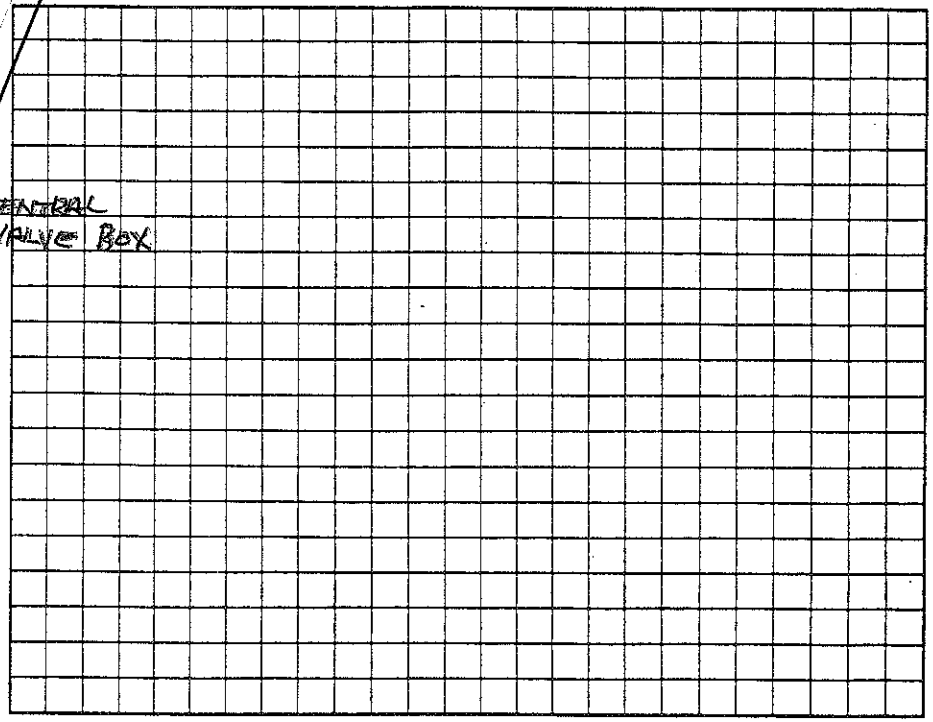

Permit can be suspended or revoked if any false information is supplied toward securing the permit/any unauthorized changes are made to the site/any unauthorized changes are made in the installation of the system. Improvement Permit with plat valid without expiration ☐ Improvement Permit with site plan valid for sixty months ☐ Authorization to Construct is valid for a period equal to that of Improvement Permit – not to exceed sixty months.

Signed: [signature] date 9/28/07 Installed by: R & H RS

Improvement Permit by: Wesley Sparks RS date 9/27/07 Operation Permit by: Marshall Dotson date 9/8/08

Authorization to Construct by: Wesley Sparks RS date 9/27/07 Existing System Inspection by: date

HEALTH DEPT. COPY: WHITE OWNER COPY (FINAL): YELLOW OWNER COPY (INITIAL): PINK