(3:00)

IREDELL COUNTY HEALTH DEPARTMENT

STATESVILLE 704-878-5305 MOORESVILLE 704-664-5281

IMPROVEMENT PERMIT / AUTHORIZATION TO CONSTRUCT / OPERATION PERMIT / EXISTING SYSTEM INSPECTION

PERMIT# 072126 PIN# 4625941684 4635 13 8170 DATE July 29, '98

OWNER OR CONTRACTOR Crescent Resources Inc. PHONE: Business Home

ADDRESS PO Box 1003, Charlotte N.C. 28202

LOCATION Brawley Sch Rd TL The Pointe DR. Queen Anne Circle to Easton Drive to Old Post Rd. to Falmouth Rd. to Barnstable Ct.

SUBDIVISION The Pointe BLOCK / SECTION 1A LOT 25 LOT AREA 42398 SITE CLASS. RS DESIGN FLOW 480gpd L.T.A.R. .25

Septic Tank: 1000 Gallons; STB 392 Date 11/10/99
Pump Tank: 1000 Gallons; PT 27 Date 2/5/98
Pump Make: MYERS Model ME3F Serial No. 8/99
Nitrification Field: No Fields 1 Square Feet 1950 Linear Feet 650
No Lines 5@130 Trench Width 36" Max Trench Bottom Depth 30" Gravel Depth 12"

☑ New System ☐ Repair System Type: I, II, (III), IV, V, VI
System Description: pumped-pm - conventional
Repair System Description: pumped-pm - 25% Reduction
Maintenance Agreement Required: ☐ Yes ☐ No

☑ House/Mod. Home No. Bedrooms 4
☐ Mobile Home No. Bathrooms 4
☐ Business No. Employees
☐ Other


☐ Slab ☑ Crawl Space ☐ Basement w/plumbing ☐ Basement wo/plumbing

Water Supply: ☐ Individual ☒ Public ☑ Community

Comments:/Conditions:
Remove any old burns/terraces

Comments:/Conditions:

INITIAL SITE SKETCH

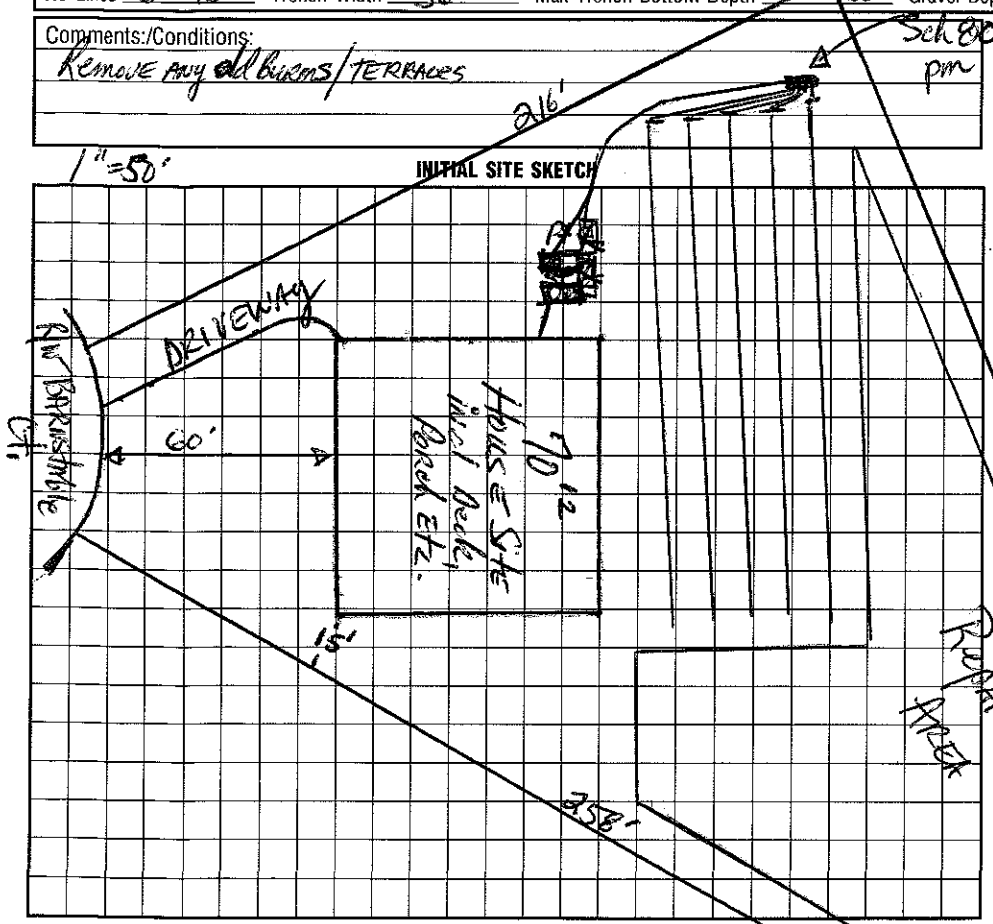

AS BUILT SKETCH

I understand that this permit can be suspended or revoked if any false information is supplied toward securing the permit/any unauthorized changes are made to the site/any unauthorized changes are made in the installation of the system. Improvement Permit with plat valid without expiration. Improvement Permit with site plan valid for sixty months. Authorization to Construct is valid for a period equal to that of Improvement Permit – not to exceed sixty months.

Signed: Paul C. Ramsey date 8-20-98 Installed by: CHRIS HENDRICK

Improvement Permit by: Wayne R. Hunsucker, RS. date 7-29-98 Operation Permit by: Wesley Sparks R.S. date 3/17/00

Authorization to Construct by: Wayne R. Hunsucker, RS. date 2-12-99 Existing System Inspection by: date

HEALTH DEPT. COPY: WHITE INSPECTION COPY (FINAL): GREEN OWNER COPY (FINAL): YELLOW INSPECTION COPY (INITIAL): PINK OWNER COPY (INITIAL): GOLD