Copy Lot (41) 4.00

IREDELL COUNTY HEALTH DEPARTMENT

STATESVILLE 704-878-5305 MOORESVILLE 704-664-5281

IMPROVEMENT PERMIT / AUTHORIZATION TO CONSTRUCT / OPERATION PERMIT / EXISTING SYSTEM INSPECTION

PERMIT# 071918 PIN# 4635-13-8587 DATE Aug. 10, 98

OWNER OR CONTRACTOR Crescent Resources Inc. - 11 Young Bld. PHONE: Business _____ Home _____

ADDRESS P.O. Box 1003, Charlotte

LOCATION Brawley Sch Rd. TL The Pointe Dr. Queen Anne Circle to Easton Dr. to Old Post Rd - 1st rd, on right @ 1st jct w/ Falmouth Rd.

SUBDIVISION The Pointe BLOCK / SECTION 1A LOT 98 LOT AREA 37,995 ft² SITE CLASS. PS DESIGN FLOW 360gpd L.T.A.R. 0.25

Septic Tank: 1000 Gallons; STB 797 Date 6/29/99

Pump Tank: 1000 Gallons; PT 27 Date 12/16/98 8/19/99

Pump Make: MYERS Model ME-50S-21 Serial No.

Nitrification Field: No Fields 1 Square Feet 810 Linear Feet 270

No Lines 3@90' Trench Width 36" Max Trench Bottom Depth 30"

☑ New System ☐ Repair System Type: I, II, III, IV, V, VI

System Description: LP Panel Block

Repair System Description: LP Panel Block

Maintenance Agreement Required: ☑ Yes ☐ No

☑ House/Mod. Home No. Bedrooms 3

☐ Mobile Home No. Bathrooms 3

☐ Business No. Employees _____

☐ Other _____

Gravel Depth N/A. ☐ Slab ☑ Crawl Space ☐ Basement w/plumbing ☐ Basement wo/plumbing


Water Supply: ☐ Individual ☑ Public ☐ Community

Comments:/Conditions: 1/2 HB

Comments:/Conditions: 12-15-98 Reviewed Site/House plans; appears in compliance w/ I.P. DRH

1"=50'

INITIAL SITE SKETCH

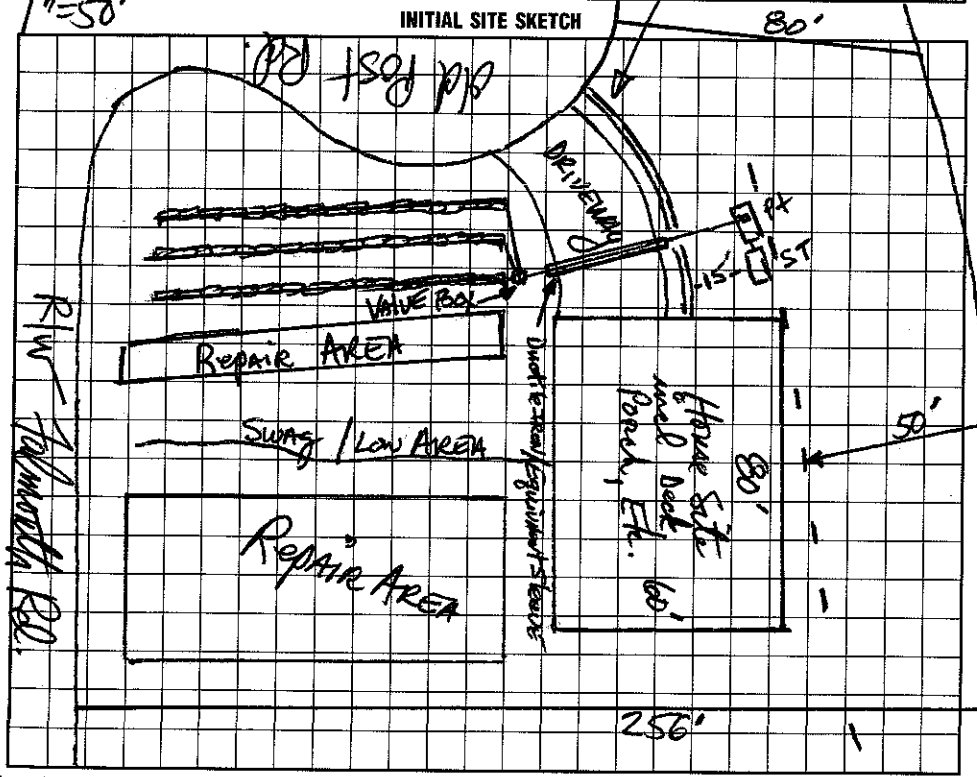

AS BUILT SKETCH

I understand that this permit can be suspended or revoked if any false information is supplied toward securing the permit/any unauthorized changes are made to the site/any unauthorized changes are made in the installation of the system. Improvement Permit with plat valid without expiration. Improvement Permit with site plan valid for sixty months. Authorization to Construct is valid for a period equal to that of Improvement Permit – not to exceed sixty months.

Signed: _____ date 8-2-98 Installed by: Wayne Dalyson

Improvement Permit by: _____ date 8/10/98 Operation Permit by: Wesley Sparks R.S. date 9/22/99

Authorization to Construct by: _____ date 12-15-98 Existing System Inspection by: _____ date _____

HEALTH DEPT. COPY: WHITE INSPECTION COPY (FINAL): GREEN OWNER COPY (FINAL): YELLOW INSPECTION COPY (INITIAL): PINK OWNER COPY (INITIAL): GOLD