IREDELL COUNTY HEALTH DEPARTMENT

STATESVILLE 704-878-5305 MOORESVILLE 704-664-5281

IMPROVEMENT PERMIT / AUTHORIZATION TO CONSTRUCT / OPERATION PERMIT / EXISTING SYSTEM INSPECTION

PERMIT# 07177 PIN# 4625941684 4635-14-2451 DATE 7/23/99

OWNER OR CONTRACTOR Crescent Resources PHONE: Business Home

ADDRESS PO Box 1003 Charlotte, NC

LOCATION Bf. Sub., Tc Pointe Dr, Queen Anne Circle, Easton Drive, Old Post, 2nd lot on Rt.

SUBDIVISION POINT BLOCK / SECTION 1A LOT 12 LOT AREA SITE CLASS: DESIGN FLOW 500 L.T.A.R. .3

Septic Tank: 1000 Gallons; STB 794 Date 1/9/99
Pump Tank: Gallons; PT Date
Pump Make: Model Serial No.
Nitrification Field: No Fields 1 Square Feet 1500 Linear Feet 500
No Lines 5@100' Trench Width 36" Max Trench Bottom Depth 36" Gravel Depth NA

☒ New System ☐ Repair System Type: I, II, (III), IV, V, VI
System Description: Grav/25 Rock
Repair System Description: Grav/Pump 25-50% Rock
Maintenance Agreement Required: ☐ Yes ☒ No

~~☐ House/Mod. Home~~ No. Bedrooms 5
☐ Mobile Home No. Bathrooms 4
☐ Business No. Employees
☐ Other


☐ Slab ☒ Crawl Space ☐ Basement w/plumbing ☐ Basement wo/plumbing

Water Supply:
☐ Individual
☒ Public
~~☐ Community~~

Comments:/Conditions:

Comments:/Conditions:

INITIAL SITE SKETCH

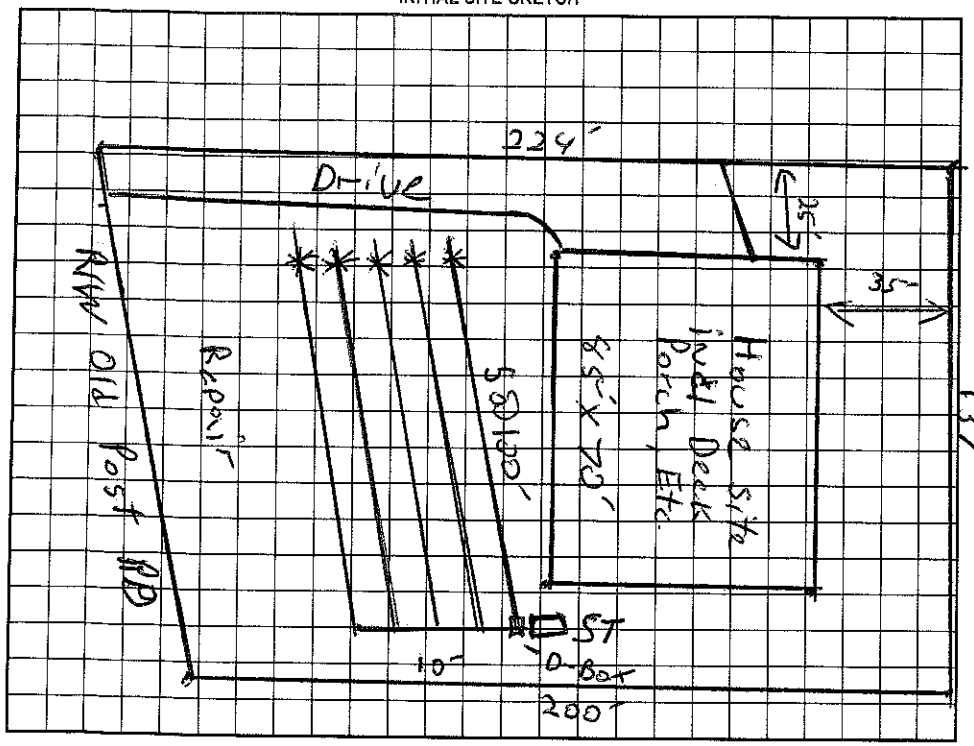

AS BUILT SKETCH

Permit can be suspended or revoked if any false information is supplied toward securing the permit/any unauthorized changes are made to the site/any unauthorized changes are made in the installation of the system. Improvement Permit with plat valid without expiration. Improvement Permit with site plan valid for sixty months. Authorization to Construct is valid for a period equal to that of Improvement Permit – not to exceed sixty months.

Signed: date 6/1/99 Installed by: Chris Hendrick

Improvement Permit by: Jeff Morgan date 7/23/99 Operation Permit by: Jeff Morgan date 7/23/99

Authorization to Construct by: Jeff Morgan date 7/23/99 Existing System Inspection by: date

HEALTH DEPT. COPY: WHITE OWNER COPY (FINAL): YELLOW OWNER COPY (INITIAL): PINK