IREDELL COUNTY HEALTH DEPARTMENT

STATESVILLE 704-878-5305 MOORESVILLE 704-664-5281

IMPROVEMENT PERMIT / AUTHORIZATION TO CONSTRUCT / OPERATION PERMIT / EXISTING SYSTEM INSPECTION

PERMIT# 071645 PIN# 4625941684 4635142616 DATE Aug 22, '98

OWNER OR CONTRACTOR Crescent Resources Inc. / Potter Bld. PHONE: Business Home

ADDRESS P.O. Box 1003, Charlotte

LOCATION Brawley Sch. Rd. TL The Pointe Dr. Queen Anne Circle to Easton Dr. ATEND on Right

SUBDIVISION The Pointe BLOCK / SECTION 1A LOT 113 LOT AREA 37,289 ft² SITE CLASS PS DESIGN FLOW 480gpd L.T.A.R. ~.3

Septic Tank: ~~1000~~ 1500 Gallons; STB 338 Date 1/9/01

Pump Tank: 1000 Gallons; PT 283 Date 12/4/00

Pump Make: Goulds Model WE05 Model No.

Nitrification Field: No Fields 1 Square Feet 1350 Linear Feet 450

No Lines 5@90' Trench Width 36" Max Trench Bottom Depth 36"

☑ New System ☐ Repair System Type: I, II, III, IV, V, VI

System Description: Pumped pm - 25% reduction

Repair System Description: LP Panel Block

Maintenance Agreement Required: ☐ Yes ☑ No initially

Gravel Depth N/A

☑ House/Mod. Home No. Bedrooms 4/4

☐ Mobile Home No. Bathrooms

☐ Business No. Employees

☐ Other

☐ Slab ☑ Crawl Space ☑ Basement w/plumbing ☐ Basement wo/plumbing

Water Supply: ☐ Individual ☒ ~~Public~~ ☒ ~~Community~~


Comments/Conditions:

7-19-00 Reviewed house/site plan; appears substantially in compliance w/ IP DSJ


Comments/Conditions: (PARTIAL) Fill old ROAD BED and ERODED AREAS. Remove old berms, terraces. *ZONE Inspection part per LATERAL.

1"=50'

INITIAL SITE SKETCH

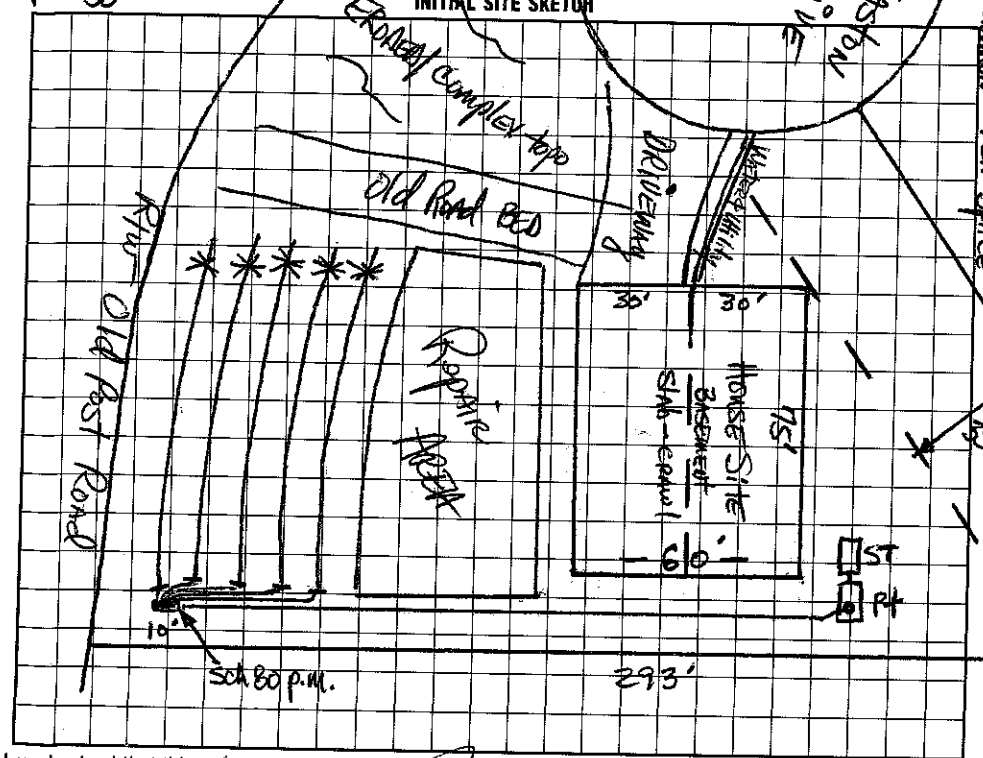

AS BUILT SKETCH

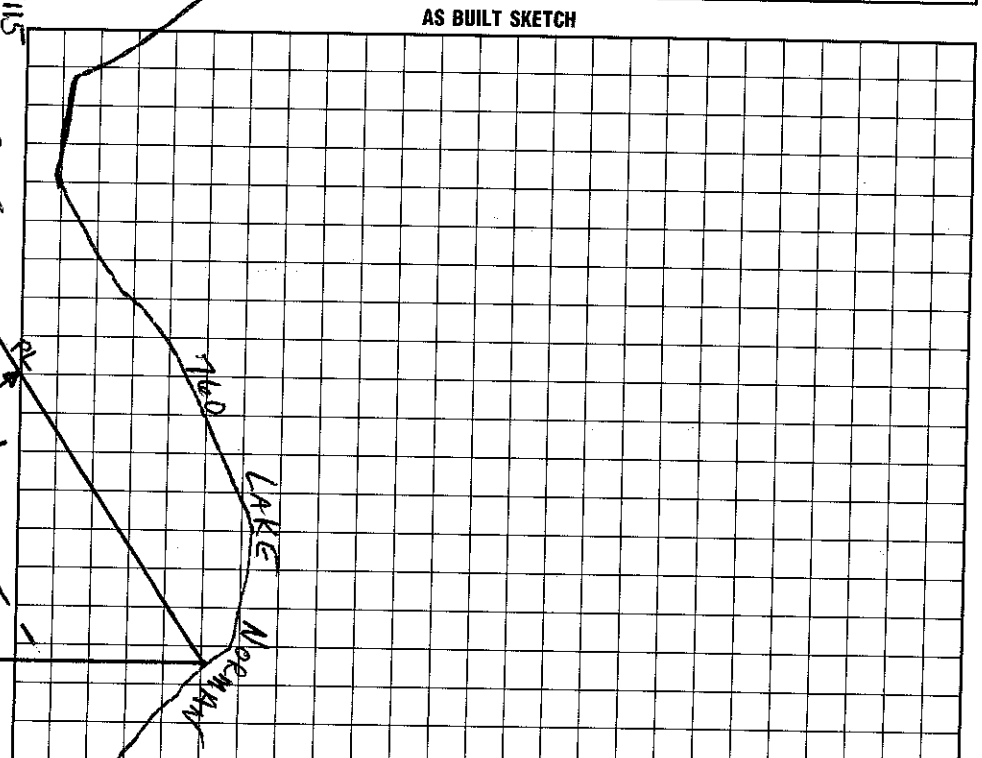

I understand that this permit can be suspended or revoked if any false information is supplied toward securing the permit/any unauthorized changes are made to the site/any unauthorized changes are made in the installation of the system. Improvement Permit with plat valid without expiration. Improvement Permit with site plan valid for sixty months. Authorization to Construct is valid for a period equal to that of Improvement Permit – not to exceed sixty months.

Signed: date 5/24/96

Improvement Permit by: date 8-22-98

Authorization to Construct by: date 7-19-00

Installed by: Stanley Septic

Operation Permit by: date 5/23/01

Existing System Inspection by: date

HEALTH DEPT. COPY: WHITE INSPECTION COPY (FINAL): GREEN OWNER COPY (FINAL): YELLOW INSPECTION COPY (INITIAL): PINK OWNER COPY (INITIAL): GOLD