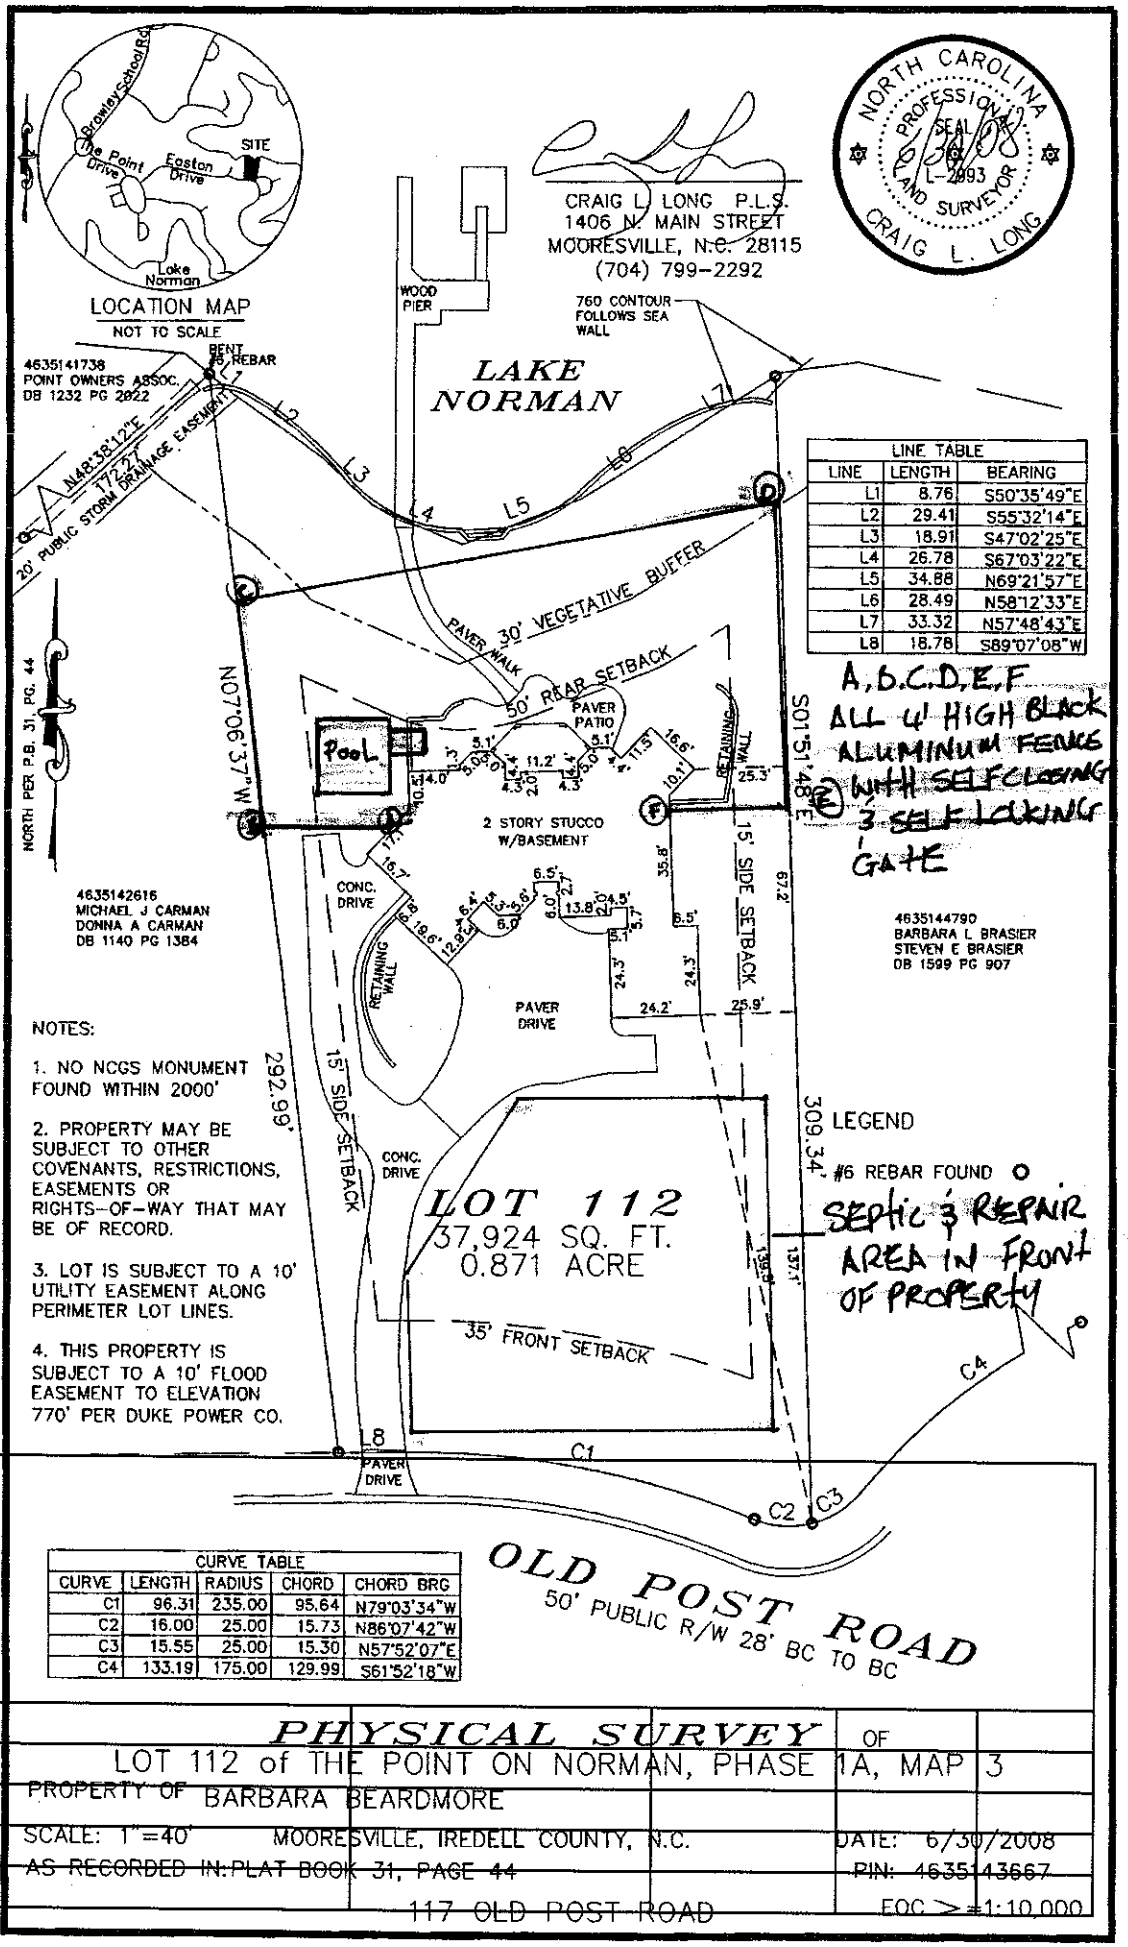


PHYSICAL SURVEY OF

LOT 112 of THE POINT ON NORMAN, PHASE 1A, MAP 3

PROPERTY OF BARBARA BEARDMORE

SCALE: 1"=40' MOORESVILLE, IREDELL COUNTY, N.C. DATE: 6/30/2008

~~AS RECORDED IN: PLAT BOOK 31, PAGE 44~~ ~~PIN: 4635143667~~

~~117 OLD POST ROAD~~ EOC > = 1:10,000

Iredell County Health Department
Environmental Health Division