IREDELL COUNTY HEALTH DEPARTMENT

STATESVILLE 704-878-5305 50.00 Paid 2:30 MOORESVILLE 704-664-5281

IMPROVEMENT PERMIT / AUTHORIZATION TO CONSTRUCT / OPERATION PERMIT / EXISTING SYSTEM INSPECTION

PERMIT# 071923 PIN# 4625 94 1684 4635 14 4061 DATE 8/7/02

OWNER OR CONTRACTOR Brookshire Const. Co. PHONE: Business 704-895-5670 Home

ADDRESS 19900 W. Catawba Ave. Cornelius, NC. 28031

LOCATION 1100 TL Pointe Dr., Queen Ann Circle TL Easton TR OH Post Rd. on (L) past Moons Entrance. 145 Old Post Rd

SUBDIVISION Pointe BLOCK / SECTION 1A LOT 103 LOT AREA 1.5Ac SITE CLASS PS DESIGN FLOW 480 L.T.A.R. .3

Septic Tank: ~~1000~~ 1500 Gallons; STB 338 Date 7/19/02

Pump Tank: 1000 Gallons; PT 283 Date 7/19/02

Pump Make: Goulds Model WE05121HH Serial No. E025155S

Nitrification Field: No Fields 1 Square Feet 1200 Linear Feet 400

No Lines 3@133' Trench Width 3 LN Max Trench Bottom Depth 30" ~~Gravel Depth~~ SAND.

[X] New System [ ] Repair System Type: I, II, III, IV, V, VI

System Description: PM → Ch. Plastic

Repair System Description: Pressure-16" PPBPS

Maintenance Agreement Required: [X] Yes [ ] No

[X] House/Mod. Home No. Bedrooms 4

[ ] Mobile Home No. Bathrooms 4

[ ] Business No. Employees

[ ] Other

[ ] Slab [ ] Crawl Space [X] Basement w/plumbing [ ] Basement wo/plumbing


Water Supply: [ ] Individual [ ] Public [X] Community

Comments:/Conditions:

Comments:/Conditions:

(1" = 50')

INITIAL SITE SKETCH

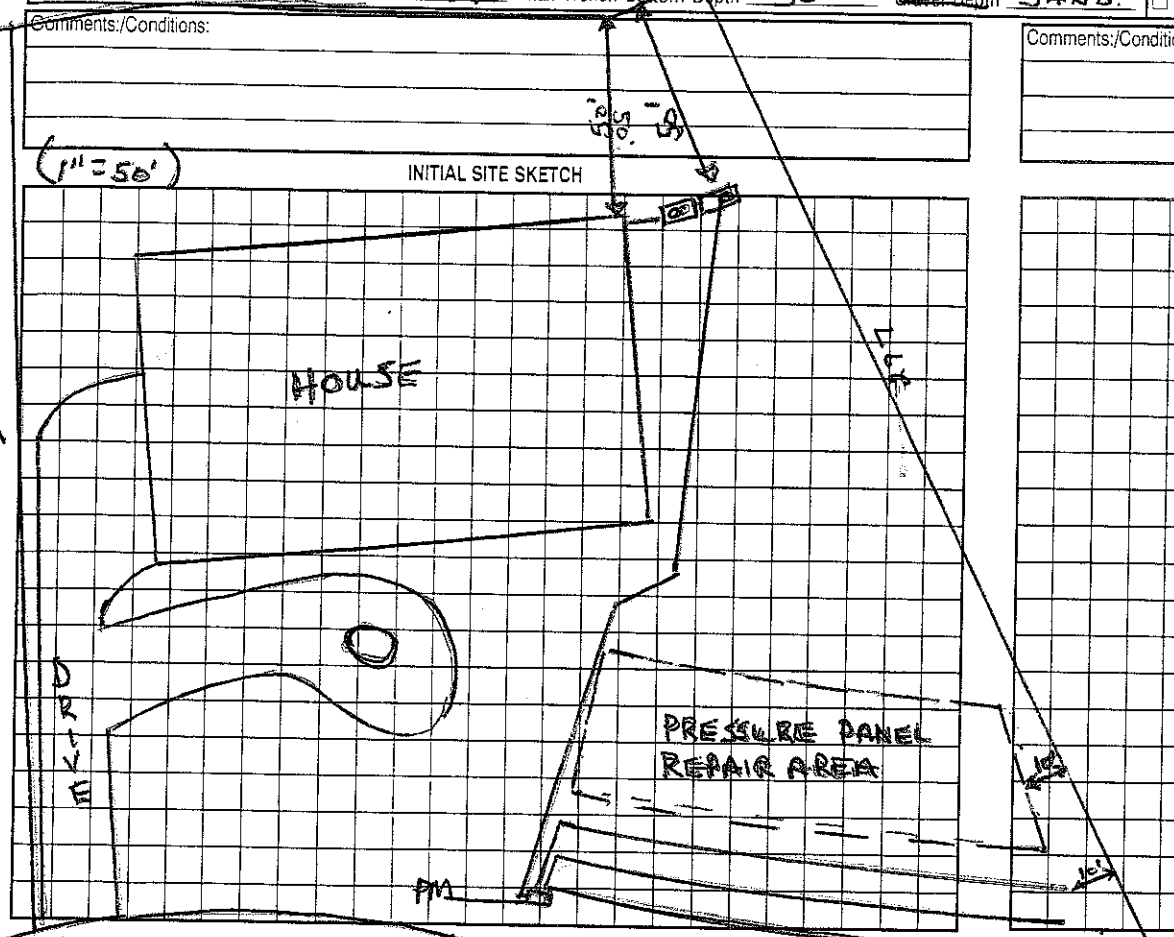

AS BUILT SKETCH

Permit can be suspended or revoked if any false information is supplied toward securing the permit/any unauthorized changes are made to the site/any unauthorized changes are made in the installation of the system. Improvement Permit with plat valid without expiration. Improvement Permit with site plan valid for sixty months. Authorization to Construct is valid for a period equal to that of Improvement Permit – not to exceed sixty months.

Signed: * date 8/19/02 Installed by: Hallman Const.

Improvement Permit by: Wesley Sparks RS. date 8/7/02 Operation Permit by: Wesley Sparks R.S. date 9/23/02

Authorization to Construct by: Wesley Sparks RS date 8/7/02 Existing System Inspection by: date

HEALTH DEPT. COPY: WHITE OWNER COPY (FINAL): YELLOW OWNER COPY (INITIAL): PINK