# IREDELL COUNTY HEALTH DEPARTMENT

STATESVILLE 704-878-5305 MOORESVILLE 704-664-5281

## IMPROVEMENT PERMIT / AUTHORIZATION TO CONSTRUCT / OPERATION PERMIT / EXISTING SYSTEM INSPECTION

PERMIT# 071621 PIN# 4625 44 6884 4635 14 4790 DATE Aug 15, 198

OWNER OR CONTRACTOR Crescent Resources Inc // David Dibble Home PHONE: Business Home

ADDRESS P.O. Box 1003 Charlotte

LOCATION Brawley Sch. Rd. TL The Pointe DR. Queen Anne Circle to Easton DR. to Old Post Rd. to Moors End

SUBDIVISION The Pointe BLOCK / SECTION 1A LOT 111 LOT AREA 35,501 ft² SITE CLASS. PS DESIGN FLOW 480gpd L.T.A.R. .03

Septic Tank: ~~1000~~ 1500 Gallons; STB 338 Date 9/15/99

Pump Tank: 1000 Gallons; PT 29 Date 12/12/99

Pump Make: MYERS Model ME 505-21 Serial No. 25325D009

Nitrification Field: No. Fields 1 Square Feet 1200 Linear Feet 400

No Lines 4@100' Trench Width 36" Max Trench Bottom Depth 36" Gravel Depth N/A

☑ New System ☐ Repair System Type: I, II, (III), IV, V, VI.

System Description: pumped-pm- 25% Reduction

Repair System Description: SAME OR LP Panel Block

Maintenance Agreement Required: ☐ Yes ☑ No

☑ House/Mod. Home No. Bedrooms 4

☐ Mobile Home No. Bathrooms 4

☐ Business No. Employees

☐ Other


☑ Slab ☑ Crawl Space ☑ Basement w/plumbing ☐ Basement wo/plumbing

Water Supply: ☐ Individual ~~☐ Public~~ ☑ Community

Comments:/Conditions: * ONE INSPECTION port per LATERAL
Remove any old burbins, terraces.
5-M-99 Reviewed house & site plan - appears in compliance w/ I.P.

Comments:/Conditions: (PARTIAL)

INITIAL SITE SKETCH 1"=50'

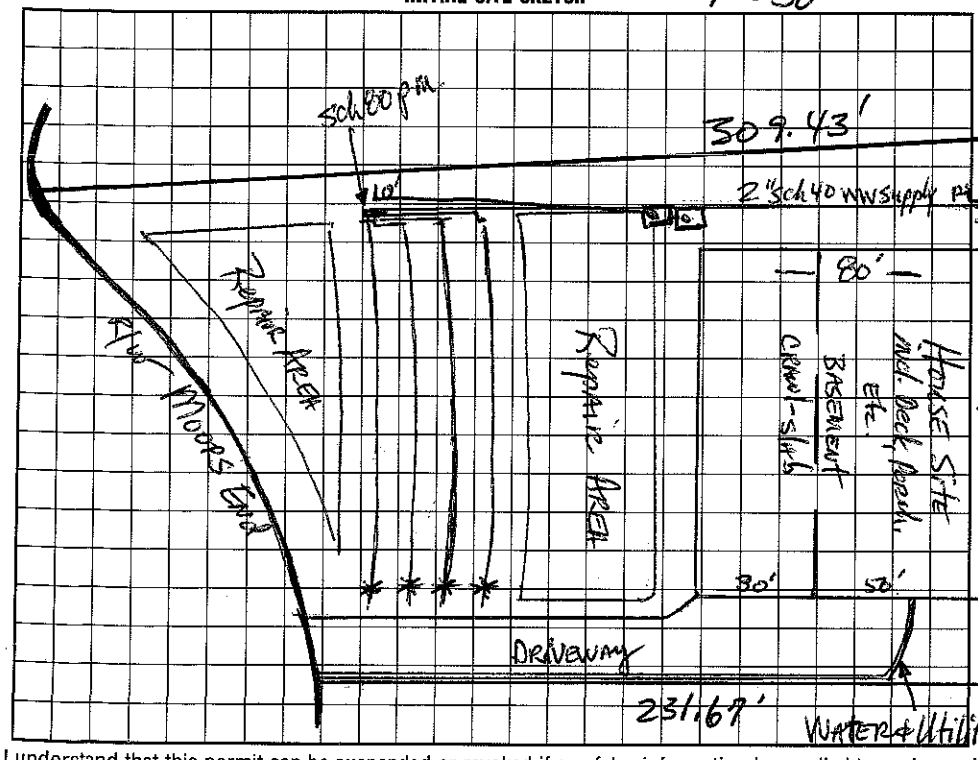


AS BUILT SKETCH

I understand that this permit can be suspended or revoked if any false information is supplied toward securing the permit/any unauthorized changes are made to the site/any unauthorized changes are made in the installation of the system. Improvement Permit with plat valid without expiration. Improvement Permit with site plan valid for sixty months. Authorization to Construct is valid for a period equal to that of Improvement Permit – not to exceed sixty months.

Signed: [signature] date 9/9/98

Improvement Permit by: [signature], RS date 9-5-98

Authorization to Construct by: [signature], RS date 5-19-99

Installed by: Orbison Const.

Operation Permit by: Wesley Sparks RS. date 5/2/00

Existing System Inspection by: date

HEALTH DEPT. COPY: WHITE INSPECTION COPY (FINAL): GREEN OWNER COPY (FINAL): YELLOW INSPECTION COPY (INITIAL): PINK OWNER COPY (INITIAL): GOLD