IREDELL COUNTY HEALTH DEPARTMENT

STATESVILLE 704-878-5305 MOORESVILLE 704-664-5281

IMPROVEMENT PERMIT / AUTHORIZATION TO CONSTRUCT / OPERATION PERMIT / EXISTING SYSTEM INSPECTIO

1100

PERMIT# 071924 PIN# 4625944684

OWNER OR CONTRACTOR Crescent Resources Inc. // Hughes Hasenbeck & Zande 4635146198 DATE Aug 13, '98

ADDRESS P.O. Box 1003, Charlotte PHONE: Business 363-6390 Home

LOCATION Brawley Sch Rd. TL The Pointe Dr. Queen Anne Circle to Easton Dr. to Old Post Rd. on left at jct w/ Moors End

SUBDIVISION The Pointe BLOCK / SECTION 1A LOT 104 LOT AREA 70,490 ft² SITE CLASS. PS DESIGN FLOW 480 gpd L.T.A.R. .3

Septic Tank: 1000 Gallons; STB 338 Date 10-15-00

Pump Tank: 1000 Gallons; PT 27 Date 8-3-00

Pump Make: Meyers Model MESD Serial No.

Nitrification Field: No Fields 1 Square Feet 1200 Linear Feet 400

No Lines 4@100 Trench Width 36" Max Trench Bottom Depth 36"

☑ New System ☐ Repair System Type: I, II, (III), IV, V, VI

System Description: Pumped - PM - 25% Reduction

Repair System Description: PM - LP 25% Reduction

Maintenance Agreement Required: ☐ Yes ☑ No

Gravel Depth NA

☑ House/Mod. Home ☐ Mobile Home ☐ Business ☐ Other

No. Bedrooms 4 No. Bathrooms 4 No. Employees

☑ Slab ☑ Crawl Space ☑ Basement w/plumbing ☐ Basement wo/plumbing

Water Supply: ☐ Individual ☑ Public ☐ Community

Comments:/Conditions: 760 LAKE NORMAN

Comments:/Conditions: (PARTIAL)


* ONE INSPECTION PORT PER LATERAL

Remove old bushes / Terraces.

6-20-2000 Reviewed house & site plan; appears substantially in compliance w/ I.P.

INITIAL SITE SKETCH

AS BUILT SKETCH

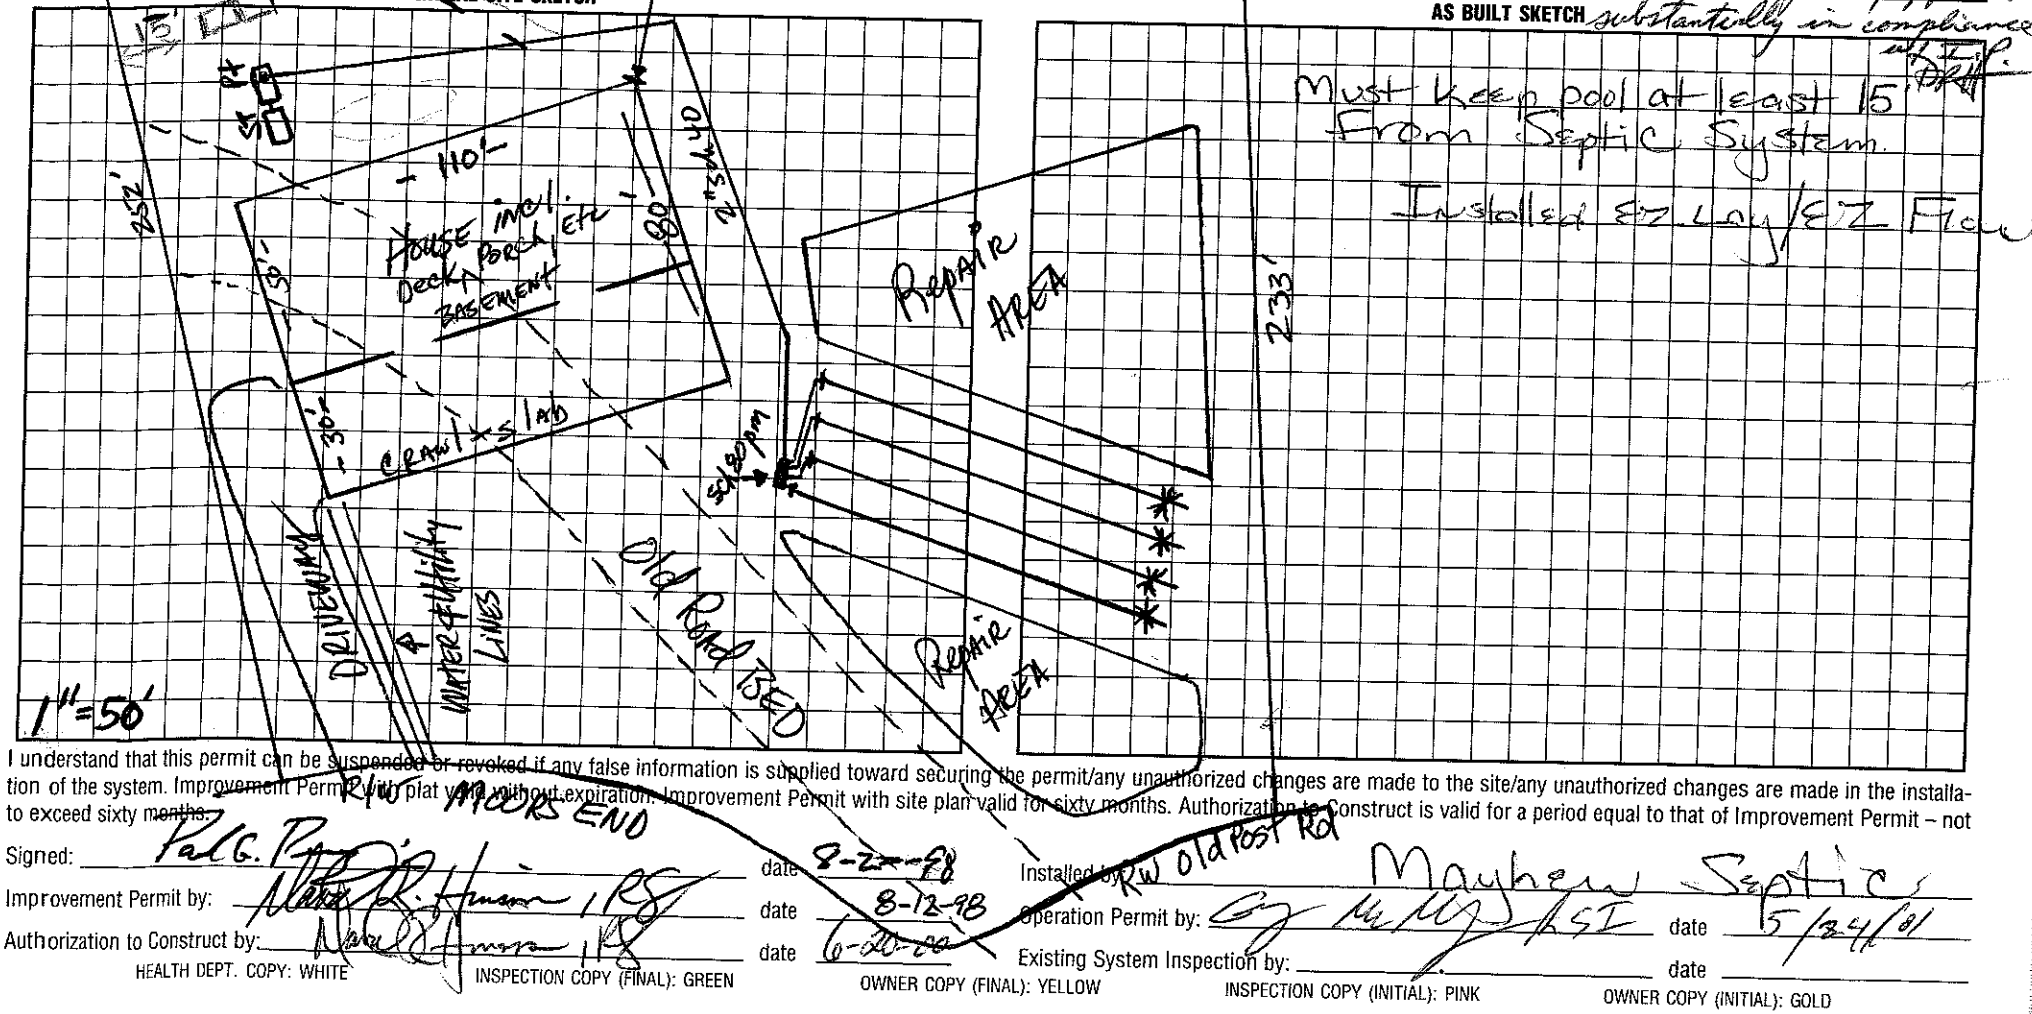

I understand that this permit can be suspended or revoked if any false information is supplied toward securing the permit/any unauthorized changes are made to the site/any unauthorized changes are made in the installation of the system. Improvement Permit with plat valid without expiration. Improvement Permit with site plan valid for sixty months. Authorization to Construct is valid for a period equal to that of Improvement Permit – not to exceed sixty ~~months~~.

Signed: Paul G. Pope

Improvement Permit by: Walter R. Hinson, IRS date 8-12-98

Authorization to Construct by: Walter R. Hinson, IRS date 6-20-00

Installer: RW Old Post Rd Mayhew Septic

Operation Permit by: [signature] ASI date 5/24/01

Existing System Inspection by: date

HEALTH DEPT. COPY: WHITE INSPECTION COPY (FINAL): GREEN OWNER COPY (FINAL): YELLOW INSPECTION COPY (INITIAL): PINK OWNER COPY (INITIAL): GOLD