1.00-2.00

IREDELL COUNTY HEALTH DEPARTMENT

STATESVILLE 704-878-5305 · MOORESVILLE 704-664-5281

IMPROVEMENT PERMIT / AUTHORIZATION TO CONSTRUCT / OPERATION PERMIT / EXISTING SYSTEM INSPECTION

PERMIT# 071620 PIN# 4625941684 DATE Aug. 15, 1998

OWNER OR CONTRACTOR Crescent Resources Chris Hwy Young Bld. PHONE: Business _____ Home _____

ADDRESS P.O. Box 1033, Charlotte

LOCATION Bagley Sch. Rd. TL The Pointe Dr. Queen Anne Circle to Easton Dr. to Old Post Rd to Moores End

SUBDIVISION The Pointe BLOCK / SECTION 1A LOT 110 LOT AREA 37,412 ft² SITE CLASS. PS DESIGN FLOW 460gpd L.T.A.R. .3

Septic Tank: 1000 Gallons; STB 799 Date 9/3/99
Pump Tank: 1000 Gallons; PT 27 Date 9/21/99
Pump Make: MYERS Model ME 503-21 Serial No. 2532D009
Nitrification Field: No Fields 1 Square Feet 1200 Linear Feet 400
No Lines 4@100' Trench Width 36" Max Trench Bottom Depth 36"

☑ New System ☐ Repair System Type: I, II, III, IV, V, VI
System Description: pumped-pg - 25% Reduction
Repair System Description: LPP/Drip Block
Maintenance Agreement Required: ☐ Yes ☑ No initially

Gravel Depth N/A


☑ House/Mod. Home ☐ Mobile Home ☐ Business ☐ Other
No. Bedrooms 4/4 No. Bathrooms _____ No. Employees _____
~~Slab~~ ~~Crawl Space~~ ~~Basement w/plumbing~~ ☐ Basement wo/plumbing

Water Supply: ☐ Individual ~~Public~~ ☑ Community


Comments:/Conditions: * ONE INSPECTION PORT PER LATERAL
Remove old houses, terraces.
3-2-99 Received house/site plan appears in compliance w/I.P. Bld to eliminate closet in study

Comments:/Conditions: (PARTIAL)
Checked inspection ports - CBF

INITIAL SITE SKETCH 1"=50'

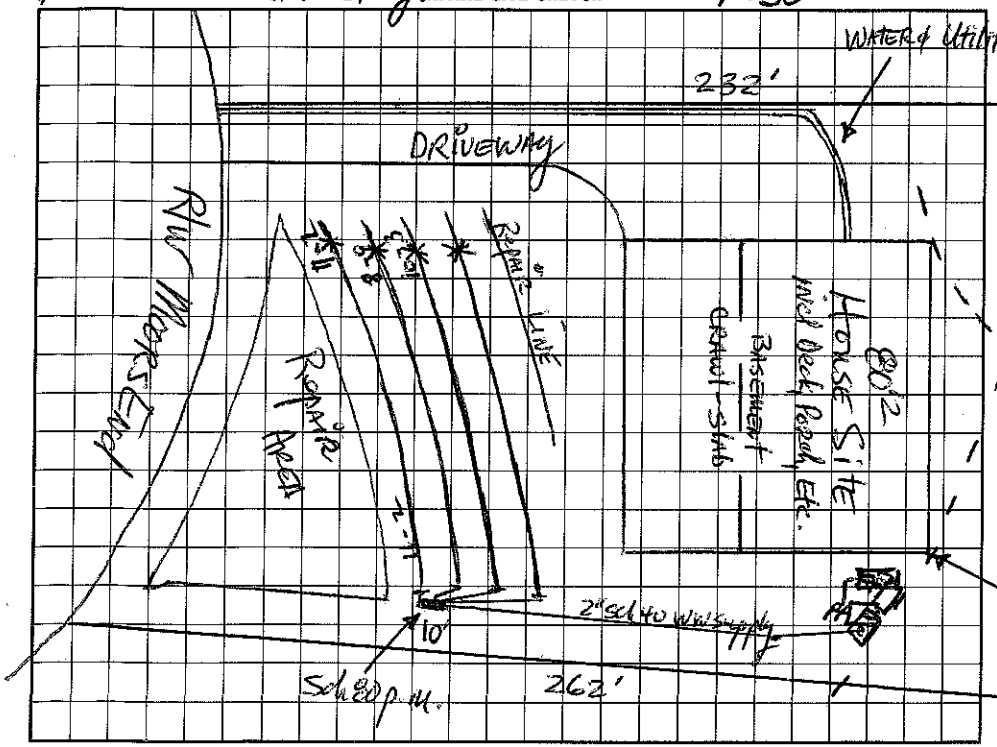

AS BUILT SKETCH

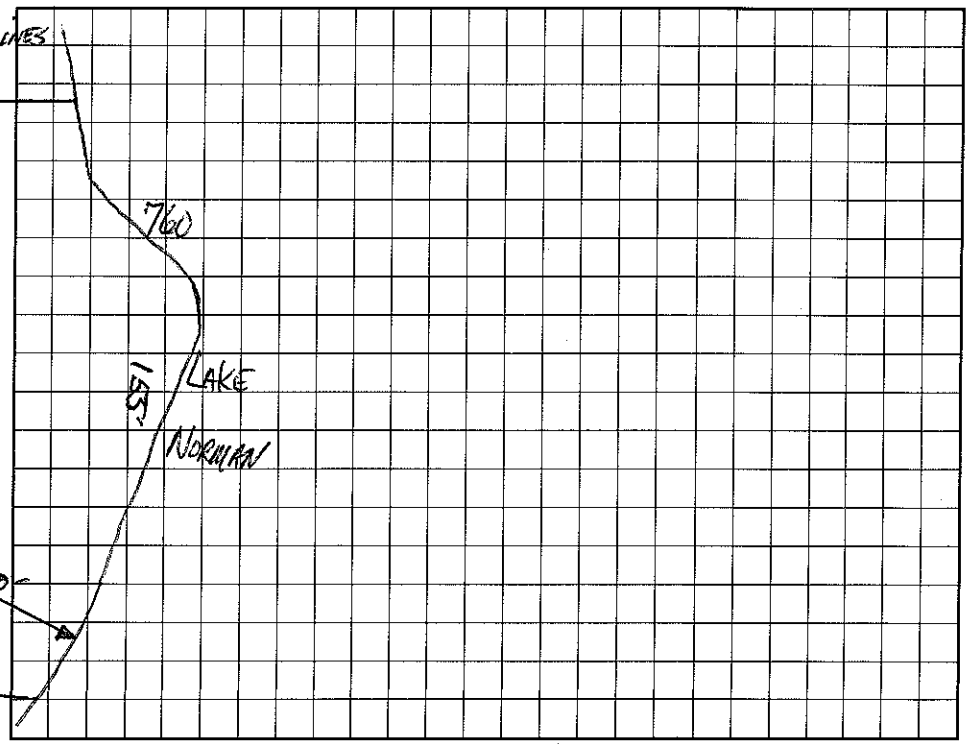

I understand that this permit can be suspended or revoked if any false information is supplied toward securing the permit/any unauthorized changes are made to the site/any unauthorized changes are made in the installation of the system. Improvement Permit with plat valid without expiration. Improvement Permit with site plan valid for sixty months. Authorization to Construct is valid for a period equal to that of Improvement Permit – not to exceed sixty months.

Signed: Paul G. Perry date 8-20-98 Installed by: Orbison Construction

Improvement Permit by: Mark R. Hinson, RS date 8-15-98 Operation Permit by: C. B. Fox date 11/25/00

Authorization to Construct by: Mark R. Hinson, RS date 3-2-99 Existing System Inspection by: _____ date _____

HEALTH DEPT. COPY: WHITE INSPECTION COPY (FINAL): GREEN OWNER COPY (FINAL): YELLOW INSPECTION COPY (INITIAL): PINK OWNER COPY (INITIAL): GOLD