IREDELL COUNTY HEALTH DEPARTMENT

STATESVILLE 704-878-5305 MOORESVILLE 704-664-5281

IMPROVEMENT PERMIT / AUTHORIZATION TO CONSTRUCT / OPERATION PERMIT / EXISTING SYSTEM INSPECTION

PERMIT# 103628 PIN# 4635-14-6721 DATE 11/28/01

OWNER OR CONTRACTOR Deborah Heinle Little PHONE: Business _____ Home _____

ADDRESS 111 Moors End Lp Mooresville NC 28117

LOCATION Brawley sch. TL Pointe Dr., Queen Anne Cir, Easton to Old Post, TL Moors End Crt.

SUBDIVISION The Pointe BLOCK / SECTION 14 LOT 110 LOT AREA 37,412 ft² SITE CLASS. PS DESIGN FLOW 480 L.T.A.R. 0.3

Septic Tank: Existing Gallons: STB _____ Date _____
Pump Tank: Existing Gallons: PT _____ Date _____
Pump Make: _____ Model _____ Serial No. _____
Nitrification Field: No Fields ____ Square Feet 1200 Linear Feet 400
No Lines 4@100' Trench Width Existing Max Trench Bottom Depth _____ Gravel Depth _____

☐ New System ☐ Repair System Type: I, II, (III), IV, V, VI
System Description: Existing 25% Reduction
Repair System Description: LP Panel Block
Maintenance Agreement Required: ☐ Yes ☒ No
☐ Slab ☒ Crawl Space ☒ Basement w/plumbing ☐ Basement wo/plumbing


☒ House/Mod. Home No. Bedrooms 4
☐ Mobile Home No. Bathrooms 4
☐ Business No. Employees ____
☐ Other _____

Water Supply:
☐ Individual
☐ Public
☒ Community


Comments:/Conditions:

Comments:/Conditions:

INITIAL SITE SKETCH

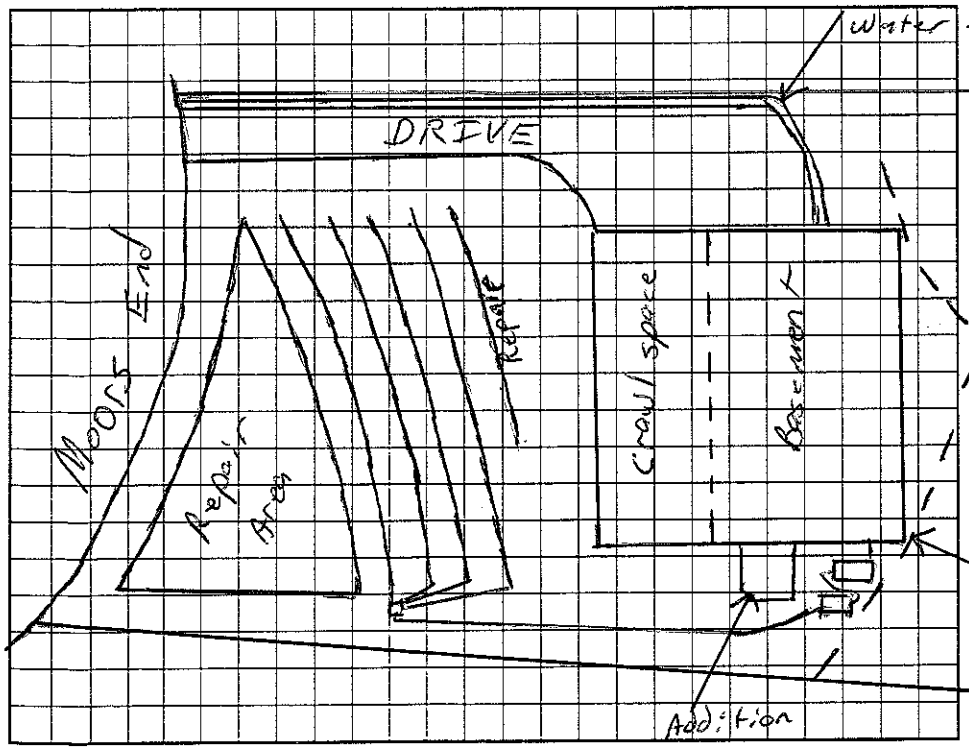

AS BUILT SKETCH

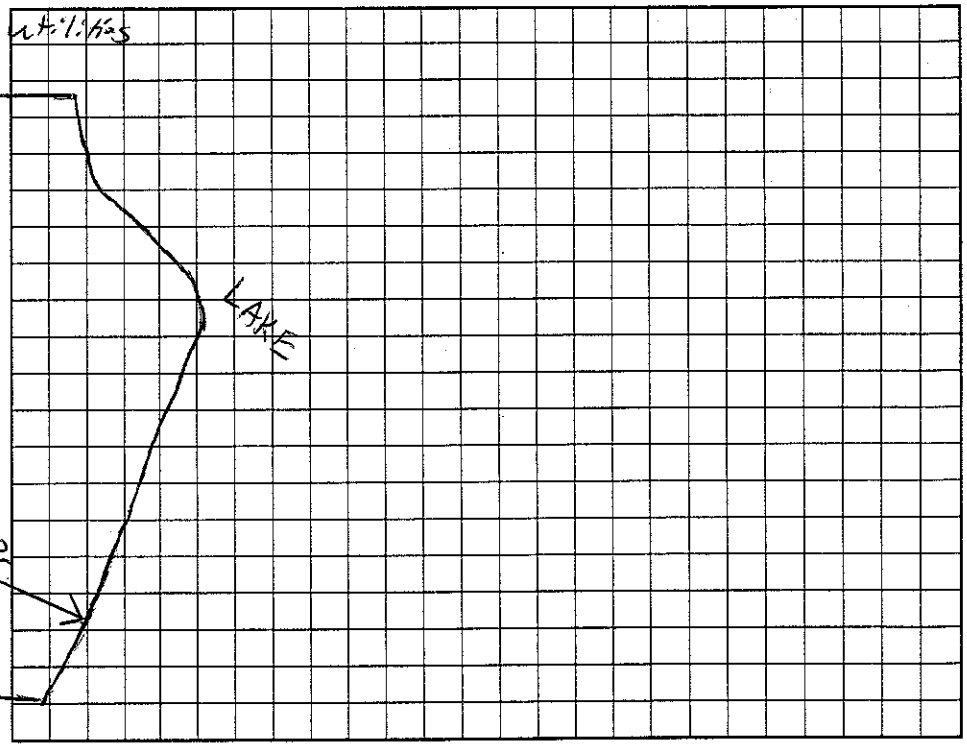

Permit can be suspended or revoked if any false information is supplied toward securing the permit/any unauthorized changes are made to the site/any unauthorized changes are made in the installation of the system. Improvement Permit with plat valid without expiration. Improvement Permit with site plan valid for sixty months. Authorization to Construct is valid for a period equal to that of Improvement Permit – not to exceed sixty months.

Signed: _____ date 12/4/01 Installed by: _____

Improvement Permit by: _____ date _____ Operation Permit by: _____ date _____

Authorization to Construct by: _____ date _____ Existing System Inspection by: _____ date 11/28/01

HEALTH DEPT. COPY: WHITE OWNER COPY (FINAL): YELLOW OWNER COPY (INITIAL): PINK