IREDELL COUNTY HEALTH DEPARTMENT

Paid 50.00

STATESVILLE 704-878-5305 MOORESVILLE 704-664-5281

IMPROVEMENT PERMIT / AUTHORIZATION TO CONSTRUCT / OPERATION PERMIT / EXISTING SYSTEM INSPECTION

PERMIT# 071619 PIN# 4625944684 4635147668 DATE 8/25/00

OWNER OR CONTRACTOR Cornerstone Builders / CRJ PHONE: Business (704) 889-8229 Home

ADDRESS PO Box 1003 Charlotte

LOCATION Brawley Sch, TL Pointe Dr, Queen Anne Cir, Easton, old Post, Moors End + Eastham Ct.

SUBDIVISION Pointe BLOCK / SECTION 1-A LOT 109 LOT AREA 36193 Ft² SITE CLASS. PS DESIGN FLOW 600 L.T.A.R. 0.3

Septic Tank: 1500 Gallons; STB Date ~~8/16/01~~ 2/16/01

Pump Tank: 1500 Gallons; PT 338 Date 2/16/01

Pump Make: Model Serial No.

Nitrification Field: No Fields 1 Square Feet 1500 Linear Feet 500

No Lines ~~5~~ Trench Width 36" Max Trench Bottom Depth 36" Gravel Depth —

☒ New System ☐ Repair System Type: I, II, (III) IV, V, VI

System Description: PM - 25% Red.

Repair System Description: LPPPBS

Maintenance Agreement Required: ☐ Yes ☒ No

☒ House/Mod. Home ☐ Mobile Home ☐ Business ☐ Other

No. Bedrooms 5 No. Bathrooms No. Employees


☒ Slab ☒ Crawl Space ☒ Basement w/plumbing ☐ Basement wo/plumbing

Water Supply: ☐ Individual ☒ Public ☐ Community


Comments:/Conditions: Remove Any of berms or Terraces, Supply line under drive way must be Sleeved in Ductile iron or equivalent

Comments:/Conditions: Checked lines 5/1/2001 MD Pressure, Elect & Alarm 8/15/2001 MD

INITIAL SITE SKETCH

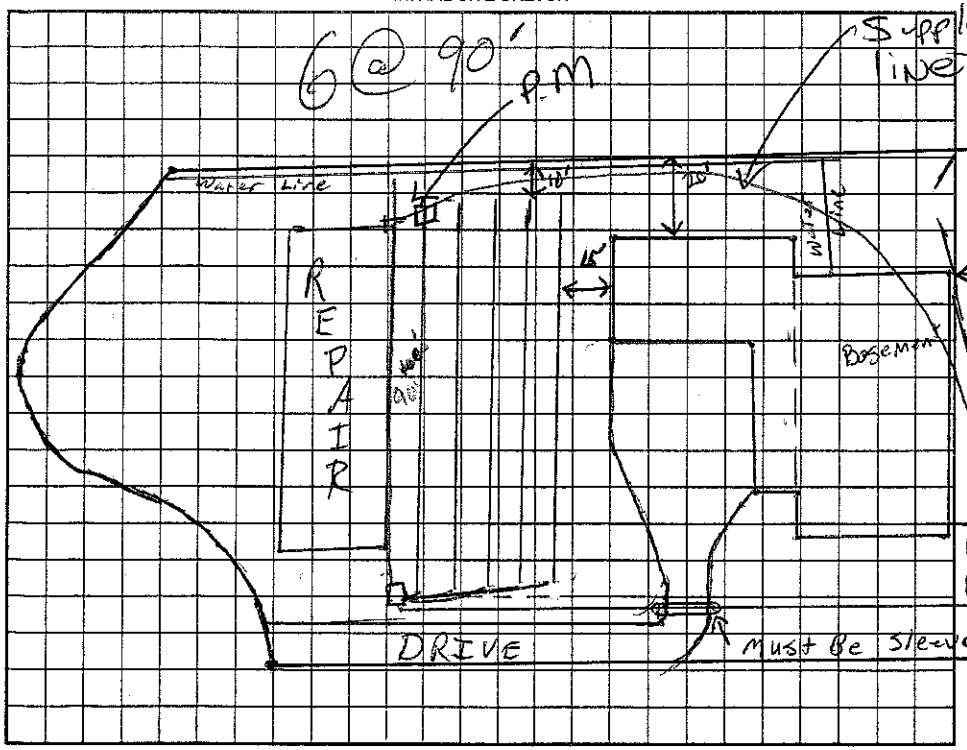

AS BUILT SKETCH

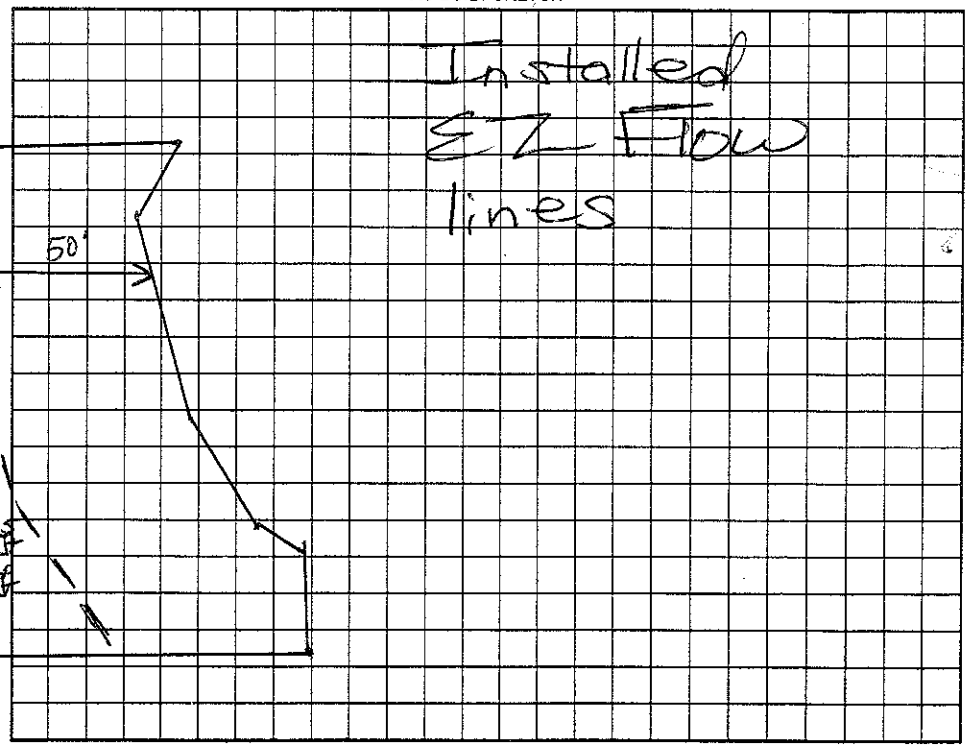

Permit can be suspended or revoked if any false information is supplied toward securing the permit/any unauthorized changes are made to the site/any unauthorized changes are made in the installation of the system. Improvement Permit with plat valid without expiration. Improvement Permit with site plan valid for sixty months. Authorization to Construct is valid for a period equal to that of Improvement Permit – not to exceed sixty months.

Signed: date 9/14/00 Installed by:

Improvement Permit by: KSE date 8/25/00 Operation Permit by: Maura H. Dotson RS date 8/15/2001

Authorization to Construct by: KSE date 8/23/00 Existing System Inspection by: date

HEALTH DEPT. COPY: WHITE OWNER COPY (FINAL): YELLOW OWNER COPY (INITIAL): PINK