IREDELL COUNTY HEALTH DEPARTMENT

STATESVILLE 704-878-5305 MOORESVILLE 704-664-5281

IMPROVEMENT PERMIT / AUTHORIZATION TO CONSTRUCT / OPERATION PERMIT / EXISTING SYSTEM INSPECTION

500.00 ta:d 1200

PERMIT# 71616 PIN# 4625944684 4635-14-9402 DATE 3/20/01

OWNER OR CONTRACTOR CRESCENT RESOURCES / AUGUSTA HOMES PHONE: Business 634-0845 Home

ADDRESS 10602 BAILEY RD CORNELIUS NC 28031

LOCATION BRAWLEY SCHOOL RD - TL POINTE DR. - QUEEN ANNE CIRCLE - TO EASTON DRIVE - OLD POST - MOORSEND

SUBDIVISION THE POINT BLOCK / SECTION 1A LOT 106 LOT AREA 37,261 ft² SITE CLASS. RS DESIGN FLOW 600 GD L.T.A.R. .3 ga1/1ft =

Septic Tank: 1500 Gallons; STB 338 Date 1-19-02

Pump Tank: 1500 Gallons; PT 338 Date 1-19-02

Pump Make: Model Serial No.

Nitrification Field: No Fields 1 Square Feet 690 Linear Feet 345

No Lines 7 Trench Width 24" Max Trench Bottom Depth 30in

☑ New System ☐ Repair System Type: I, II, III, IV, V, VI

System Description: LP PANEL

Repair System Description: LP PANEL OFFSITE

Maintenance Agreement Required: ☑ Yes ☐ No

Gravel Depth N/A

☑ House/Mod. Home ☐ Mobile Home ☐ Business ☐ Other

No. Bedrooms 5 No. Bathrooms 5 No. Employees


☐ Slab ☐ Crawl Space ☑ Basement w/plumbing ☐ Basement wo/plumbing

Water Supply: ☐ Individual ☐ Public ☑ Community


Comments:/Conditions: REVISED TO 5BR AND REPAIR OFFSITE BECAUSE OF NEIGHBOR'S WELL. - SEE ATTACHED

Comments:/Conditions: Checked lower 3 lines 2/19/2002 Checked upper 4 lines 2/20/2002 MS Pressure, electrical & alarm 10/18/02

INITIAL SITE SKETCH

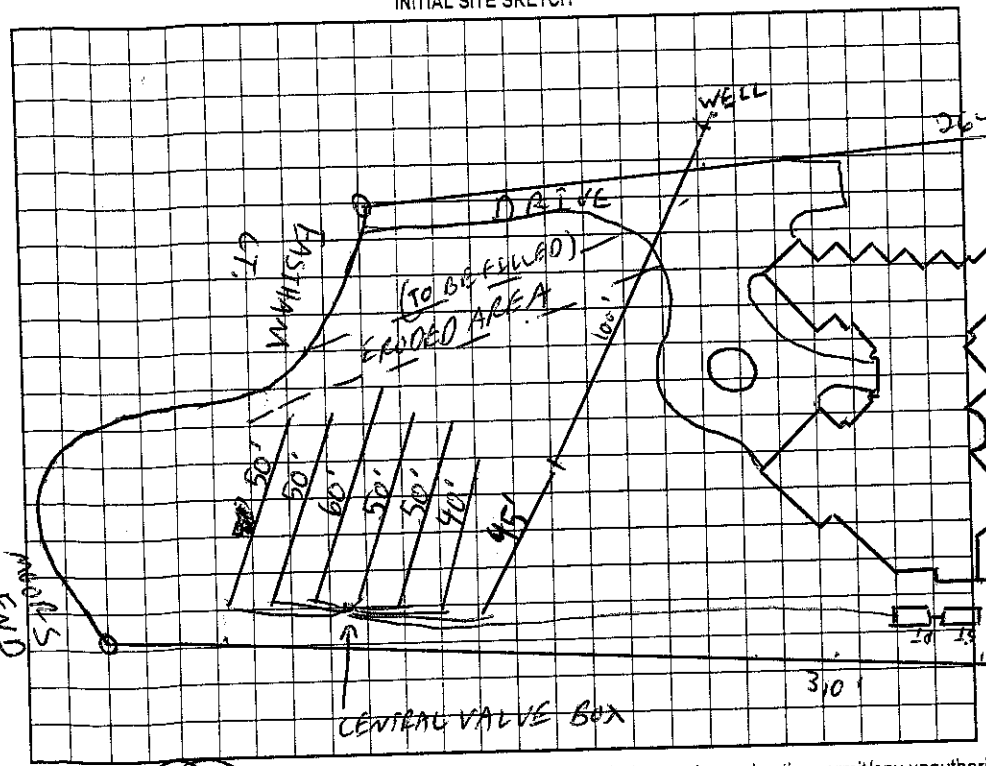

AS BUILT SKETCH

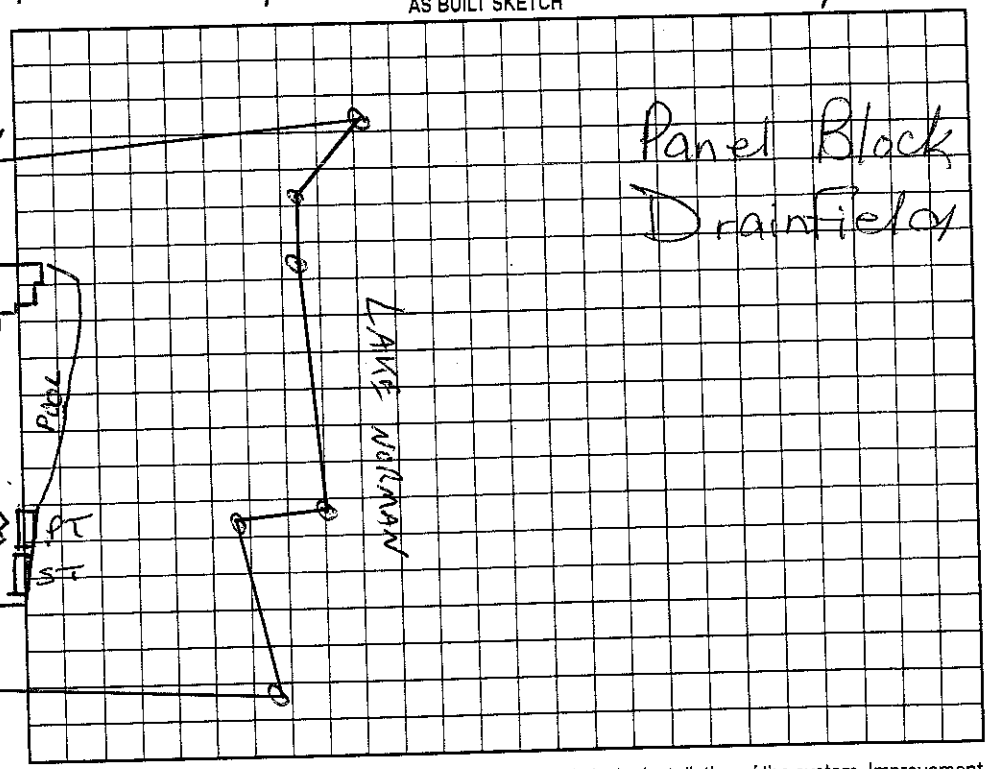

Permit can be suspended or revoked if any false information is supplied toward securing the permit/any unauthorized changes are made to the site/any unauthorized changes are made in the installation of the system. Improvement Permit with plat valid without expiration. Improvement Permit with site plan valid for sixty months. Authorization to Construct is valid for a period equal to that of Improvement Permit – not to exceed sixty months.

Signed: date 3/21/01 Installed by: R. H. Jones RS

Improvement Permit by: C. Ray Jones RS date 3/20/01 Operation Permit by: Mona H. Dotson RS date 10/18/02

Authorization to Construct by: C. Ray Jones RS date 3/20/01 Existing System Inspection by: date

HEALTH DEPT. COPY: WHITE OWNER COPY (FINAL): YELLOW OWNER COPY (INITIAL): PINK