IREDELL COUNTY HEALTH DEPARTMENT

STATESVILLE 704-878-5305 500.00 Paid MOORESVILLE 704-664-5281

IMPROVEMENT PERMIT / AUTHORIZATION TO CONSTRUCT / OPERATION PERMIT / EXISTING SYSTEM INSPECTION

PERMIT# 7/618 PIN# ~~4625941684~~ 4635-14-9617 DATE 3/20/01

OWNER OR CONTRACTOR CRESCENT RESOURCES / DIENST CUSTOM HOMES PHONE: Business _____ Home _____

ADDRESS PO BOX 1003 CHARLOTTE

LOCATION BRAWLEY SCHOOL - TL POINTE DRIVE - @ - TL EASTON DRIVE - TR OLD POST - MOORSEND - (SYSTEM WITHIN CIRCLE)

SUBDIVISION POINTE BLOCK / SECTION 1A LOT 108/108A LOT AREA 49,669 SITE CLASS PS DESIGN FLOW 600 L.T.A.R. .30 PD/FT2

Septic Tank: 1500 Gallons; STB 197 Date ~~8-21-99~~

Pump Tank: 1500 Gallons; PT 338 Date ~~2-25-01~~

Pump Make: Meyers Model Me100 Serial No. _____

Nitrification Field: No. Fields 1 Square Feet 1200 Linear Feet 400

No Lines 3@134' Trench Width EXISTING (36") Max Trench Bottom Depth 36-40" Gravel Depth N/A

☑ New System ☐ Repair System Type: I, II, III, IV, V, VI

System Description: LOW PRESSURE PANEL

Repair System Description: SAME

Maintenance Agreement Required: ☑ Yes ☐ No

☑ House/Mod. Home No. Bedrooms 5

☐ Mobile Home No. Bathrooms 5

☐ Business No. Employees _____

☐ Other _____


☑ Slab ☑ Crawl Space ☑ Basement w/plumbing ☐ Basement wo/plumbing

Water Supply: ☐ Individual ☐ Public ☑ Community


Comments:/Conditions: 1) REMOVE EXISTING CHAMBERS IN TRENCH.
2) DIG OUT BOTTOM OF TRENCH SLIGHTLY
3) REPLACE PANELS IN SAME TRENCH AS CHAMBERS
4) REMOVE PRESSURE MANIFOLD AND CHANGE TO CENTRAL VALVE BOX

Comments:/Conditions: 5) REMOVE 1000 GALLON PUMP TANK AND REPLACE WITH 1500 GALLON PUMP TANK
6) UPGRADING FROM 4BR to 5BR 7) EASEMENT LINE CHANGED SLIGHTLY.

INITIAL SITE SKETCH

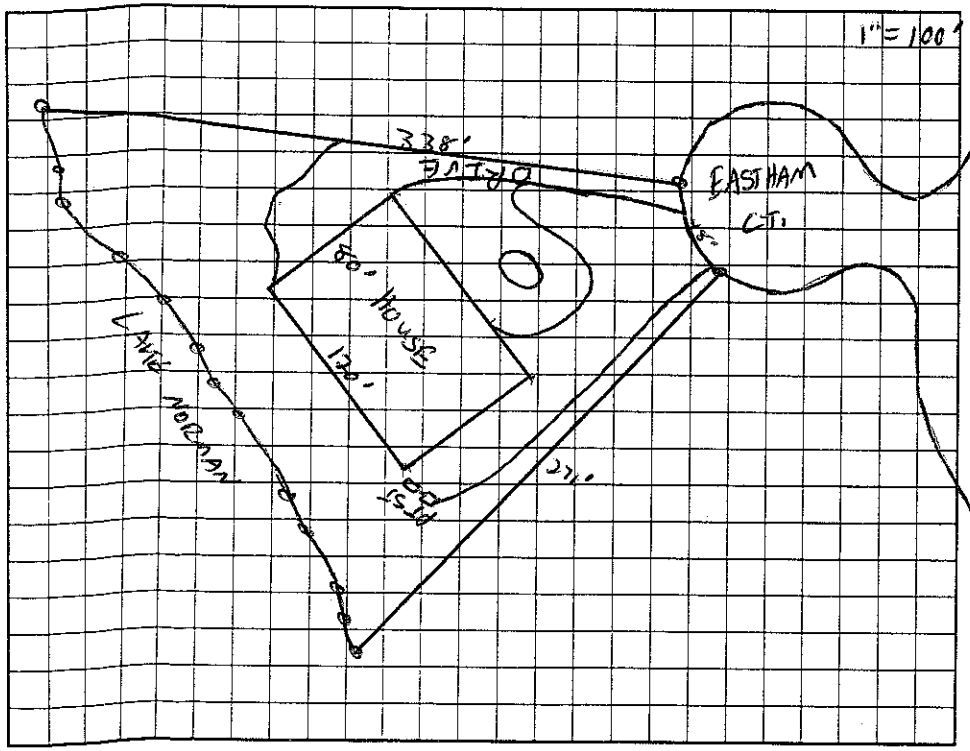

AS BUILT SKETCH

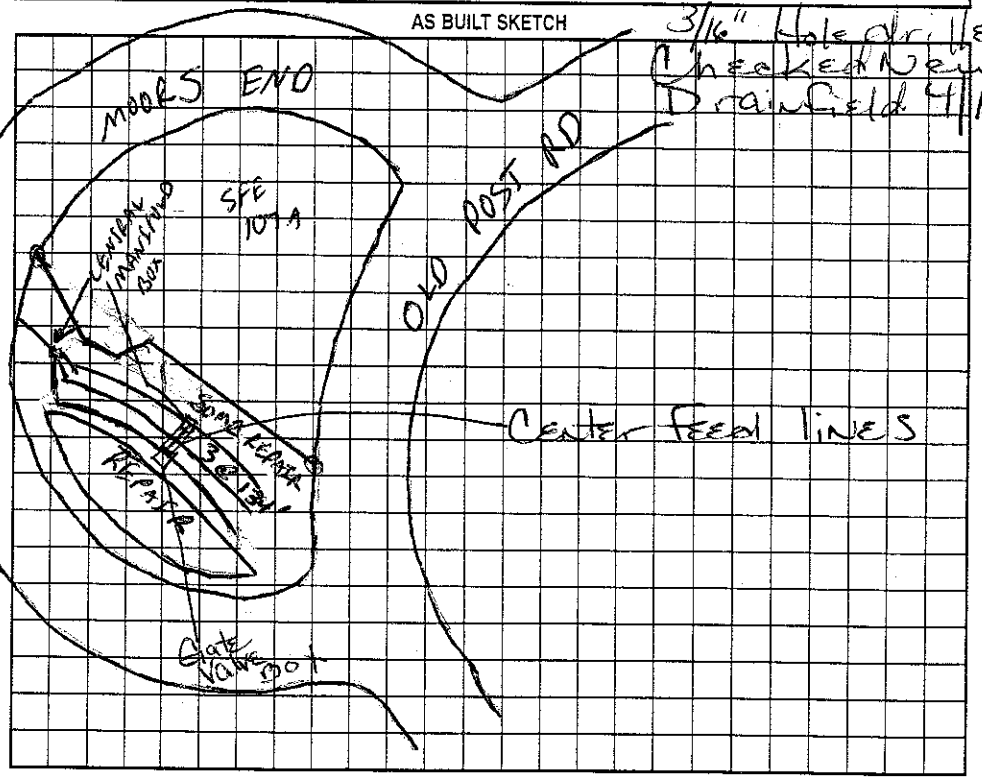

Permit can be suspended or revoked if any false information is supplied toward securing the permit/any unauthorized changes are made to the site/any unauthorized changes are made in the installation of the system. Improvement Permit with plat valid without expiration. Improvement Permit with site plan valid for sixty months. Authorization to Construct is valid for a period equal to that of Improvement Permit – not to exceed sixty months.

Signed: Darrell Hoke date 3/23/01 Installed by: R & H

Improvement Permit by: C. Bryan Ferguson RS date 3/20/01 Operation Permit by: Maria H. Watson RS date 5/18/2001

Authorization to Construct by: C. Bryan Ferguson RS date 3/20/01 Existing System Inspection by: _____ date _____

HEALTH DEPT. COPY: WHITE OWNER COPY (FINAL): YELLOW OWNER COPY (INITIAL): PINK