IREDELL COUNTY HEALTH DEPARTMENT

Statesville Office (704) 878-5305 Mooresville Office (704) 660-3625 PERMIT # 212442

IMPROVEMENT PERMIT / AUTHORIZATION TO CONSTRUCT / OPERATION PERMIT / EXISTING SYSTEM

PIN # 4635149617

APPLICANT: Michael Lamach / WHB Inc. APPLICANT ADDRESS: P.O. Box 4301 Mooresville, NC 28117

SITE ADDRESS: 107 Eastham Ct Mooresville, NC 28117 PHONE: 704 799-9500 ALT. PHONE: 704 309 4301 Dave

SITE DIRECTIONS: Brawley School Rd to Point Left @ Circle TL Easton Drive TR Old Post TL Moors End TL Eastham

SUBDIVISION: The Pointe on Norman SECTION: 1A LOT # 108/108A LOT AREA: 1.140 Acres DESIGN FLOW: 600gpd L.T.A.R.: .3

Existing

Septic Tank	1500 (gal)	STB	Date	☐ New System ☐ Repair ☐ Expansion	System Type: I II III (IV) V VI
Pump Tank	1500 (gal)	PT	Date	System Description: Exist. LP PPBPS	
Pump Make		Model	Serial #	Repair System Description: Same	
# Nitrification Fields	1	# Lines 3	Linear Ft: 400'	Maintenance Agreement Required: ☒ YES ☐ NO	
Trench Width	36"	Max. Trench Bottom Depth 36"-40"		Gravel Depth N/A	☐ GRAVITY ☒ PRESSURE

☒ Residence ☐ Business ☐ Other ☐ Slab ☒ Basement w/plumbing


No. Bedrooms 5 No. Persons 10 No. Employees ☐ Crawl Space

Water Supply: ☐ Private ☒ Public ☒ Community ☐ Basement w/o plumbing


Comments / Conditions:

The proposed/existing Pool Pavilion does not appear to impact the existing septic system.

INITIAL SITE SKETCH

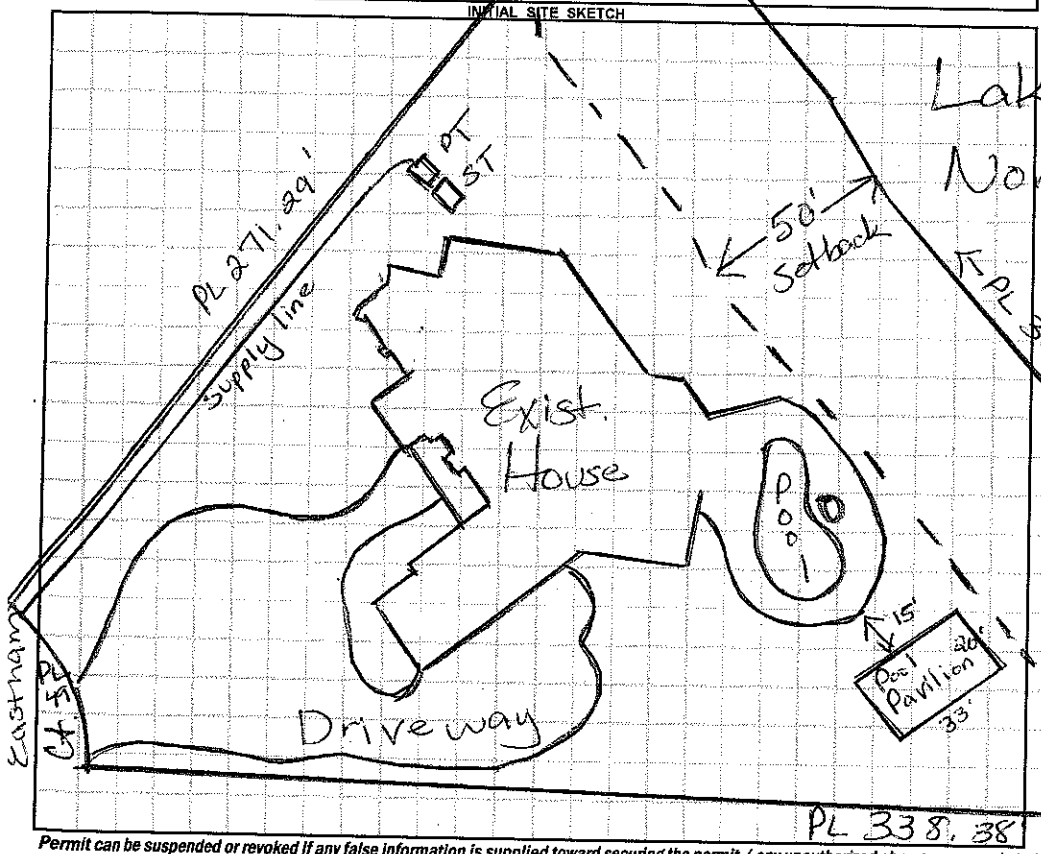

AS BUILT SKETCH

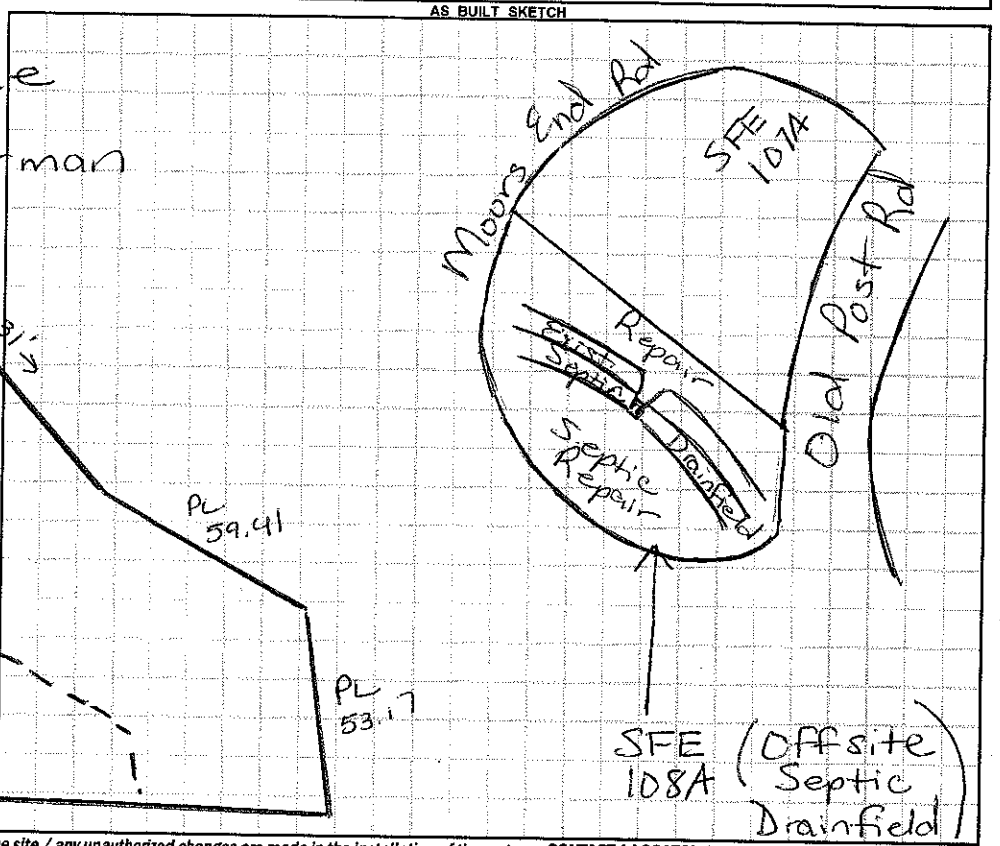

Permit can be suspended or revoked if any false information is supplied toward securing the permit / any unauthorized changes are made to the site / any unauthorized changes are made in the installation of the system. **CONTACT A LOCATOR SERVICE PRIOR TO ANY EXCAVATION**

☐ **IMPROVEMENT PERMIT** *with plat valid without expiration.* ☐ **IMPROVEMENT PERMIT** *with site plan valid for 60 mos.* ☐ **AUTHORIZATION TO CONSTRUCT** *valid for period equal to IMPROVEMENT PERMIT--not to exceed 60 mo.*

Owner / Applicant Signature: Date: 9/2/15 Installed by:

IMPROVEMENT PERMIT by: Date: OPERATION PERMIT by: Date:

AUTHORIZATION TO CONSTRUCT by: Date: Existing System Inspected by: Maria Dotson RS Date: 8/31/15

Health Dept. Copy - WHITE Applicant (Final Approval) - YELLOW Applicant (Conditional Approval) - PINK