IREDELL COUNTY HEALTH DEPARTMENT

STATESVILLE 704-878-5305 MOORESVILLE 704-664-5281

IMPROVEMENT PERMIT / AUTHORIZATION TO CONSTRUCT / OPERATION PERMIT / EXISTING SYSTEM INSPECTION

PERMIT# 073869 PIN# ~~4625944684~~ 4635151678 DATE April 28, '99

OWNER OR CONTRACTOR NORMAN OER PHONE: Business Home

ADDRESS 19143 Oak Leaf Circle Cornelius 28031

LOCATION Brawley Sch Rd TL Chatham TR Kingsbury Cts on Right

SUBDIVISION The Point BLOCK / SECTION I-B LOT 10 LOT AREA 51,663 ~~ft²~~ SITE CLASS. I 45 DESIGN FLOW 600gpd T.A.R. .3

Septic Tank: 1500 Gallons; STB 338 Date 5/15/00
Pump Tank: 1500 Gallons; PT 338 Date 5/15/00
Pump Make: MYERS Model ME-50S21 Serial No. 25325D009
Nitrification Field: No Fields 1 Square Feet 1500 Linear Feet 500
No Lines 6 @ 100' Trench Width 36" Max Trench Bottom Depth 36" Gravel Depth

☑ New System ☐ Repair System Type: I, II, III, IV, V, VI
System Description: PM - INNOVATIVE / 25% Red.
Repair System Description: LP Panel Blocks
Maintenance Agreement Required: ☐ Yes ☑ No

☑ House/Mod. Home No. Bedrooms 5
☐ Mobile Home No. Bathrooms 6
☐ Business No. Employees
☐ Other

☑ Slab ☐ Crawl Space ☑ Basement w/plumbing ☐ Basement wo/plumbing


Water Supply: ☐ Individual ☑ Public ☐ Community

Comments:/Conditions: ONE Inspection port per LATERAL. Property fill gallied area


Comments:/Conditions: PM box damaged some in landscaping Sprinkling heavily today.

1" = 50'

INITIAL SITE SKETCH

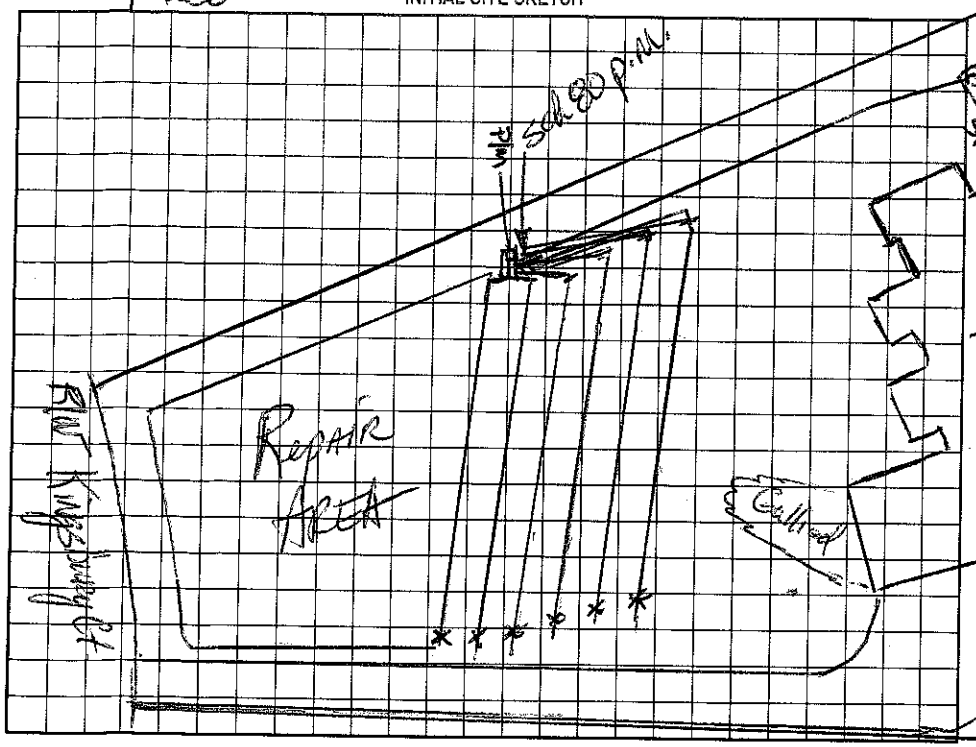

AS BUILT SKETCH

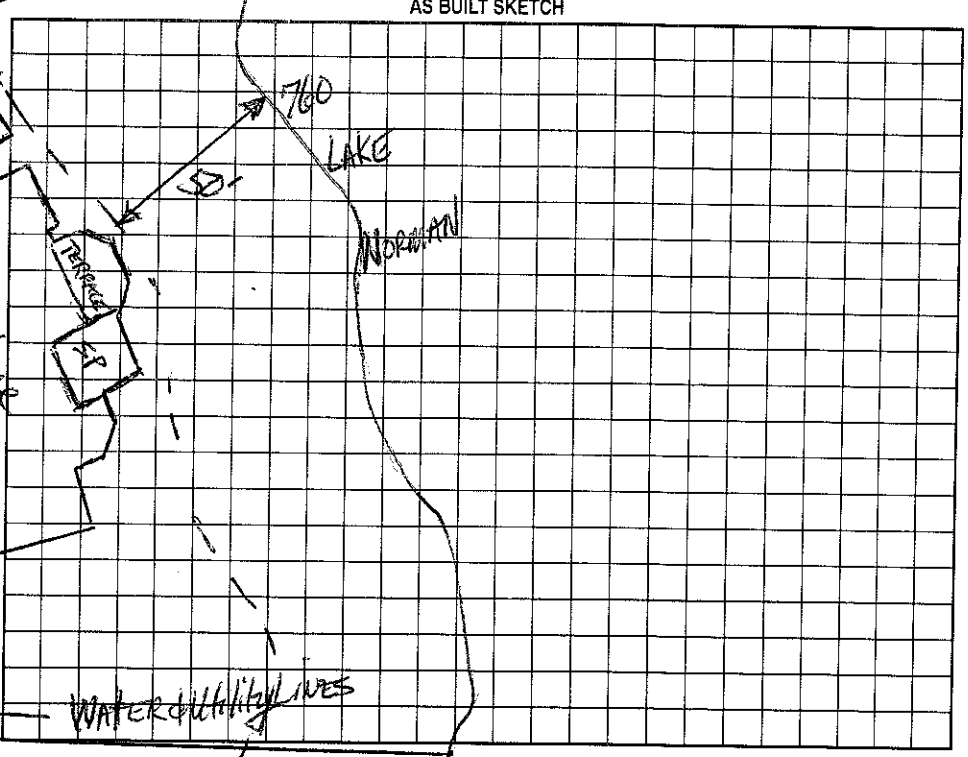

Permit can be suspended or revoked if any false information is supplied toward securing the permit/any unauthorized changes are made to the site/any unauthorized changes are made in the installation of the system. Improvement Permit with plat valid without expiration. Improvement Permit with site plan valid for sixty months. Authorization to Construct is valid for a period equal to that of Improvement Permit – not to exceed sixty months.

Signed: date 7/28/99 Installed by: F J Ervin

Improvement Permit by: date 4-28-99 Operation Permit by: Wesley Sparks RS date 4/12/01

Authorization to Construct by: date 4-28-99 Existing System Inspection by: date

HEALTH DEPT. COPY: WHITE OWNER COPY (FINAL): YELLOW OWNER COPY (INITIAL): PINK