IREDELL COUNTY HEALTH DEPARTMENT

Statesville Office (704) 878-5305 Mooresville Office (704) 660-3625 PERMIT # 217064

IMPROVEMENT PERMIT / AUTHORIZATION TO CONSTRUCT / OPERATION PERMIT / EXISTING SYSTEM

PIN # 4635151678

APPLICANT: Travis Walk APPLICANT ADDRESS: Po Box 1546, Cornelius

SITE ADDRESS: 108 Kingsbury Ct. - Mooresville PHONE: 704-333-8999 ALT. PHONE: N/A

SITE DIRECTIONS: BSR to Chatham TL Kingsbury Ct

SUBDIVISION: The Point on Norman SECTION: IBM2 LOT # 10 LOT AREA: 1.18 acres DESIGN FLOW: 600gpd L.T.A.R.: Existing


Septic Tank	Existing (gal)	STB	Date	☐ New System ☐ Repair ☐ Expansion	System Type: I II (III) IV V VI	☑ Residence	No. Bedrooms 5
Pump Tank	Existing (gal)	PT	Date	System Description:	Existing	☐ Business	No. Persons 10
Pump Make		Model	Serial #	Repair System Description:		☐ Other	No. Employees
# Nitrification Fields	Ex	# Lines Ex	Linear Ft: Ex	Maintenance Agreement Required:	☐ YES ☑ NO	☐ Slab	☐ Crawl Space
Trench Width	Ex	Max. Trench Bottom Depth	Ex	Gravel Depth Ex	☐ GRAVITY ☑ PRESSURE	☑ Basement w/plumbing	☐ Basement w/o plumbing

Water Supply: ☐ Private ☑ Public ☐ Community


Comments / Conditions:

- Maintain a minimum of 5' between cabana foundation & all components of septic tank system.

INITIAL SITE SKETCH

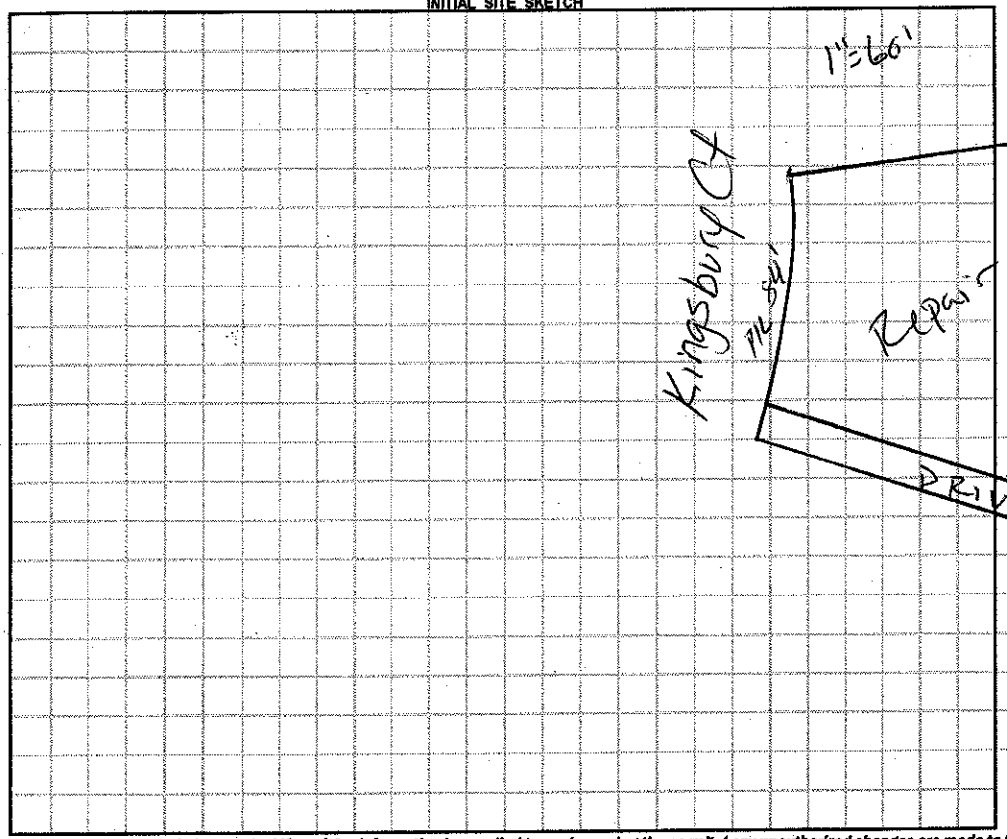

AS BUILT SKETCH

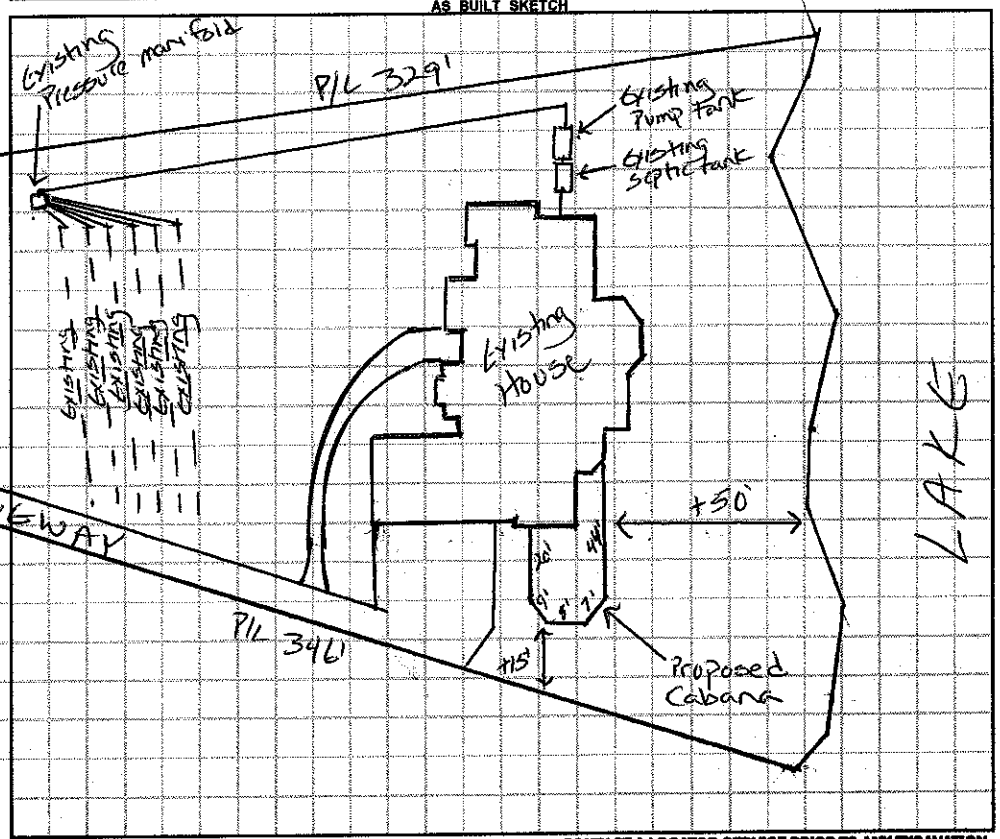

Permit can be suspended or revoked if any false information is supplied toward securing the permit / any unauthorized changes are made to the site / any unauthorized changes are made in the installation of the system. **CONTACT A LOCATOR SERVICE PRIOR TO ANY EXCAVATION**

☐ **IMPROVEMENT PERMIT *with plat*** *valid without expiration.* ☐ **IMPROVEMENT PERMIT *with site plan*** *valid for 60 mos.* ☐ **AUTHORIZATION TO CONSTRUCT** *valid for period equal to IMPROVEMENT PERMIT--not to exceed 60 mo.*

Owner / Applicant Signature: [signature] Date: 3-15-16 Installed by:

IMPROVEMENT PERMIT by: Date: OPERATION PERMIT by: Date:

AUTHORIZATION TO CONSTRUCT by: Date: Existing System Inspected by: Justin Anderson Date: 3-8-16

Health Dept. Copy - WHITE Applicant (Final Approval) - YELLOW Applicant (Conditional Approval) - PINK