IREDELL COUNTY HEALTH DEPARTMENT

STATESVILLE 704-878-5305 MOORESVILLE 704-664-5281

IMPROVEMENT PERMIT / AUTHORIZATION TO CONSTRUCT / OPERATION PERMIT / EXISTING SYSTEM INSPECTION

PERMIT# 073870 PIN# 4625941684 4655-15-1877 DATE Sept. 12, 1998

OWNER OR CONTRACTOR Crescent Resources clo Mr. Ken Koontz PHONE: Business _____ Home _____

ADDRESS P.O. Box 1003, Charlotte

LOCATION Brawley Sch. Rd. TL Chatham Rd. TL Kingsbury Ct. on Right 114

SUBDIVISION The Pointe BLOCK / SECTION 1-B LOT 11 LOT AREA 70,817 sq ft SITE CLASS. PS DESIGN FLOW 480gpd L.T.A.R. 0.25

Septic Tank: 1500 + Gallons; STB 338 Date 5/20/00

Pump Tank: 1000 Gallons; PT 27 Date 3/21/00

Pump Make: MYERS Model ME50-52 Serial No. _____

Nitrification Field: No Fields 1 Square Feet 1500 Linear Feet 500

No Lines 5@100 Trench Width 36" Max Trench Bottom Depth 24" Gravel Depth NA

☑ New System ☐ Repair System Type: I, II, III, IV, V, VI

System Description: pumped-pm- 25% Reduction

Repair System Description: SAME + LPP

Maintenance Agreement Required: ☐ Yes ☑ No

☑ House/Mod. Home ☐ Mobile Home ☐ Business ☐ Other

No. Bedrooms 4 No. Bathrooms 4 No. Employees _____

☑ Slab ☑ Crawl Space ☑ Basement w/plumbing ☐ Basement wo/plumbing


Water Supply: ☐ Individual ☐ ~~Public~~ ☑ ~~Community~~

Comments:/Conditions: Fill ERODED AREAS. INSTALL SYSTEM EXACTLY where shown on site sketch.
* ONE inspection port per LATERAL 238.21'
Fill ERODED AREAS.


Comments:/Conditions: (PARTIAL)

1" = 50'

INITIAL SITE SKETCH

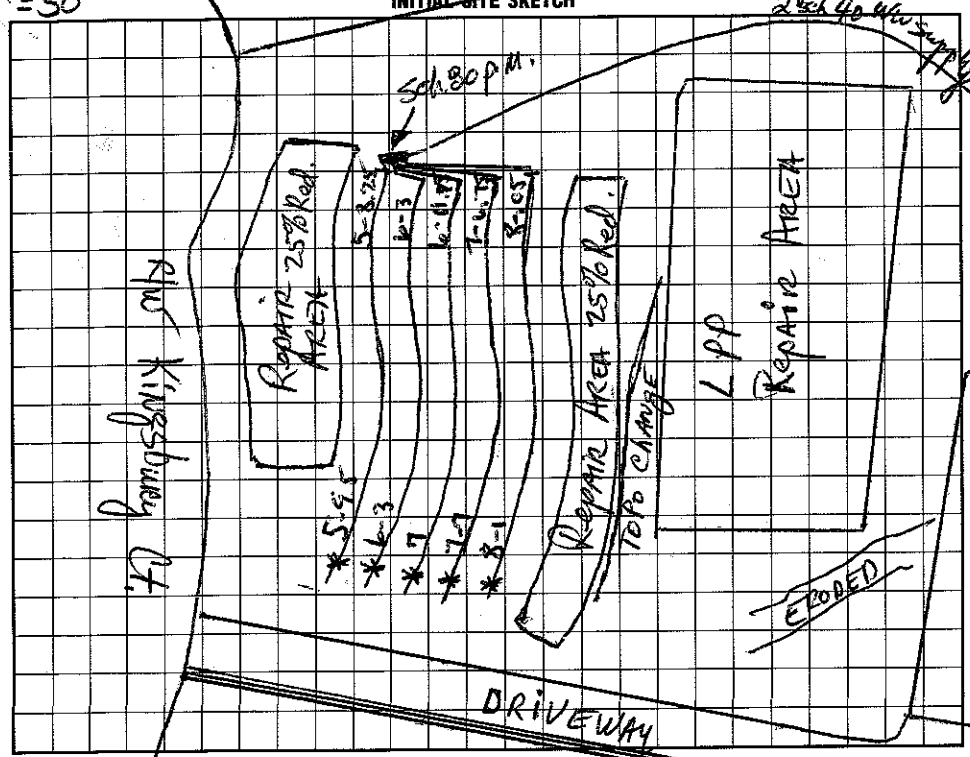

AS BUILT SKETCH

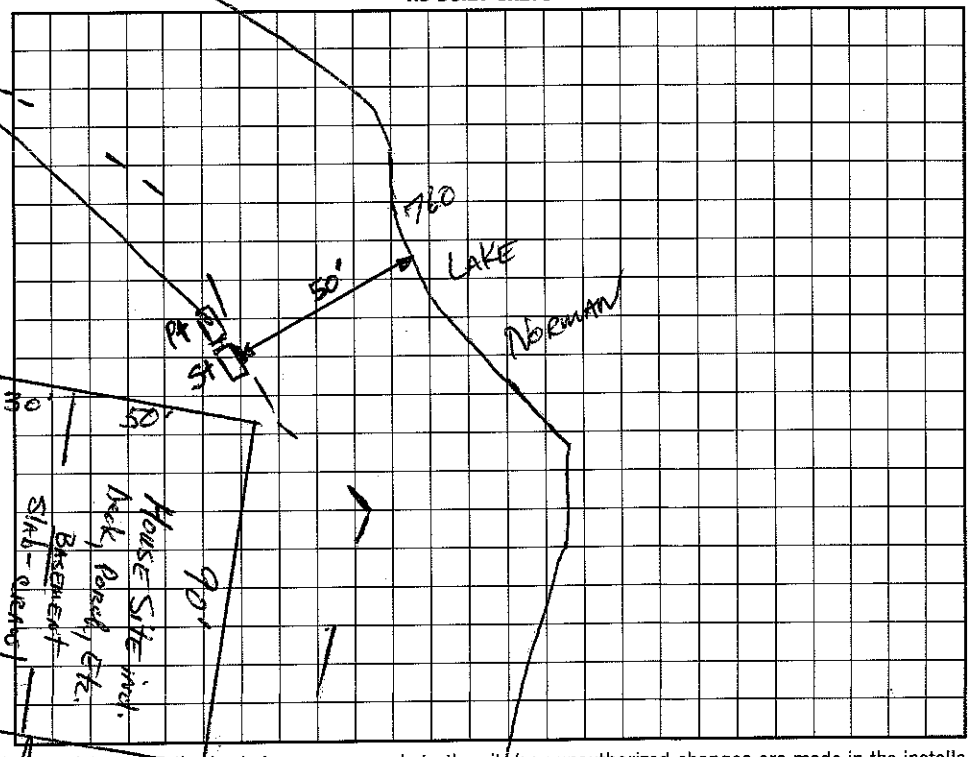

I understand that this permit can be suspended or revoked if any false information is supplied toward securing the permit/any unauthorized changes are made to the site/any unauthorized changes are made in the installation of the system. Improvement Permit with plat valid without expiration. Improvement Permit with site plan valid for sixty months. Authorization to Construct is valid for a period equal to that of Improvement Permit – not to exceed sixty months.

Signed: _____ Agent date 10/15/98

Improvement Permit by: _____ RS date 9-12-98

Authorization to Construct by: _____ RS date 4-13-99

Installed by: F.J. Ervin

Operation Permit by: Wesley Sparkman date 8/16

Existing System Inspection by: _____ date _____

HEALTH DEPT. COPY: WHITE INSPECTION COPY (FINAL): GREEN OWNER COPY (FINAL): YELLOW INSPECTION COPY (INITIAL): PINK OWNER COPY (INITIAL): GOLD