IREDELL COUNTY HEALTH DEPARTMENT

STATESVILLE 704-878-5305 MOORESVILLE 704-664-5281

IMPROVEMENT PERMIT / AUTHORIZATION TO CONSTRUCT / OPERATION PERMIT / EXISTING SYSTEM INSPECTION

PERMIT# 073891 PIN# 4625946684 (pt) 4635-16-1737 DATE Sept. 15, 98

OWNER OR CONTRACTOR Crescent Resources Inc. PHONE: Business Home

ADDRESS P.O. Box 1003, Charlotte

LOCATION Brawley Sch Rd. TL Chatham Rd. TL Mayfair Rd. on Right past Forestdale Loop

SUBDIVISION The Pointe BLOCK / SECTION 1-B LOT 26 LOT AREA 37,338 ft² SITE CLASS. PS DESIGN FLOW 480gpd L.T.A.R. .3

Septic Tank: ~~1000~~ 1500 Gallons; STB 338 Date 11/18/00

Pump Tank: Gallons; PT Date

Pump Make: Model Serial No.

Nitrification Field: No. Fields 1 Square Feet 1200 Linear Feet 400

No Lines @ 80' Trench Width 36" Max Trench Bottom Depth 36" Gravel Depth NA

☑ New System ☐ Repair System Type: I, II, III, IV, V, VI

System Description: GRAVITY 25% Reduction

Repair System Description: SAME

Maintenance Agreement Required: ☐ Yes ☑ No

☑ House/Mod. Home No. Bedrooms 4

☐ Mobile Home No. Bathrooms 4

☐ Business No. Employees

☐ Other


☑ Slab ☑ Crawl Space ☐ Basement w/plumbing ☐ Basement wo/plumbing

Water Supply: ☐ Individual ☑ Public ☑ Community


Comments:/Conditions: *ONE INSPECTION PORT PER LATERAL.
6-16-99 Reviewed home & site plan, appears in compliance w/ FP DPH

Comments:/Conditions: 27 Elbow installed
Septic tank moved to accomodate addition, tank is 7ft from addition.
3/7/2001 MD

INITIAL SITE SKETCH

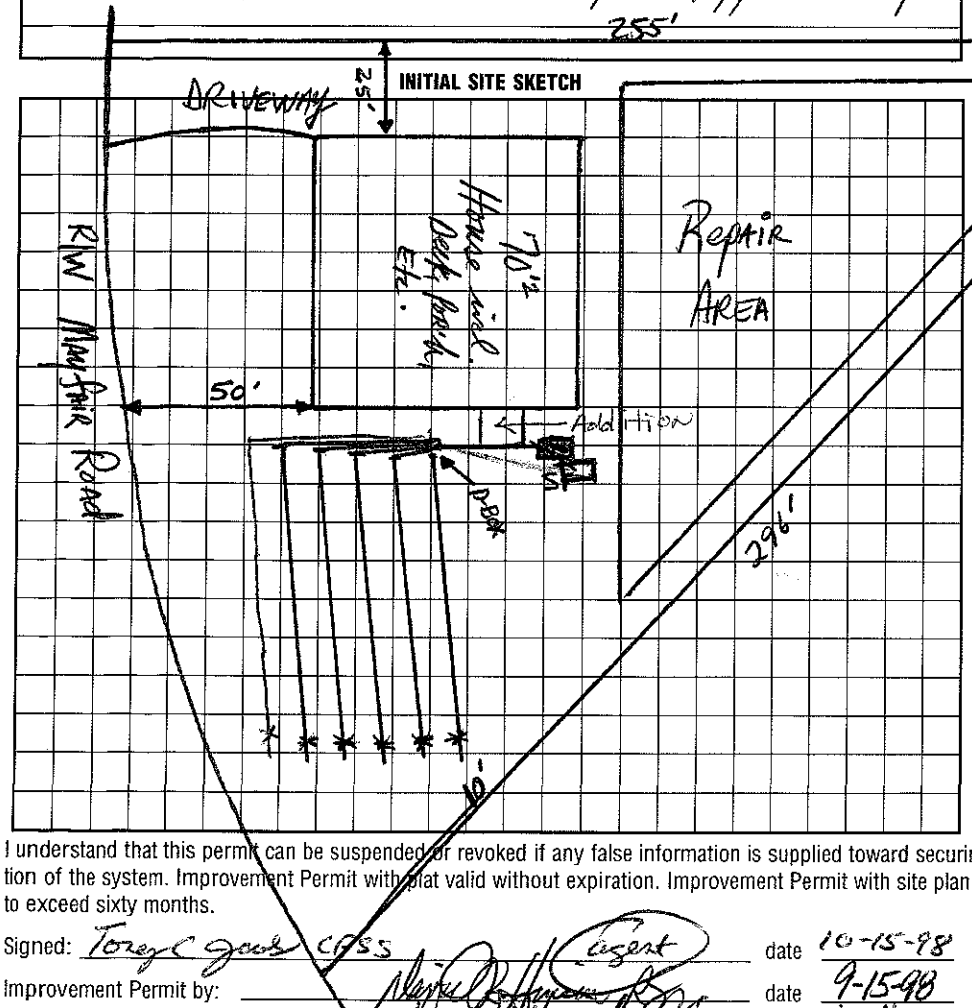

AS BUILT SKETCH

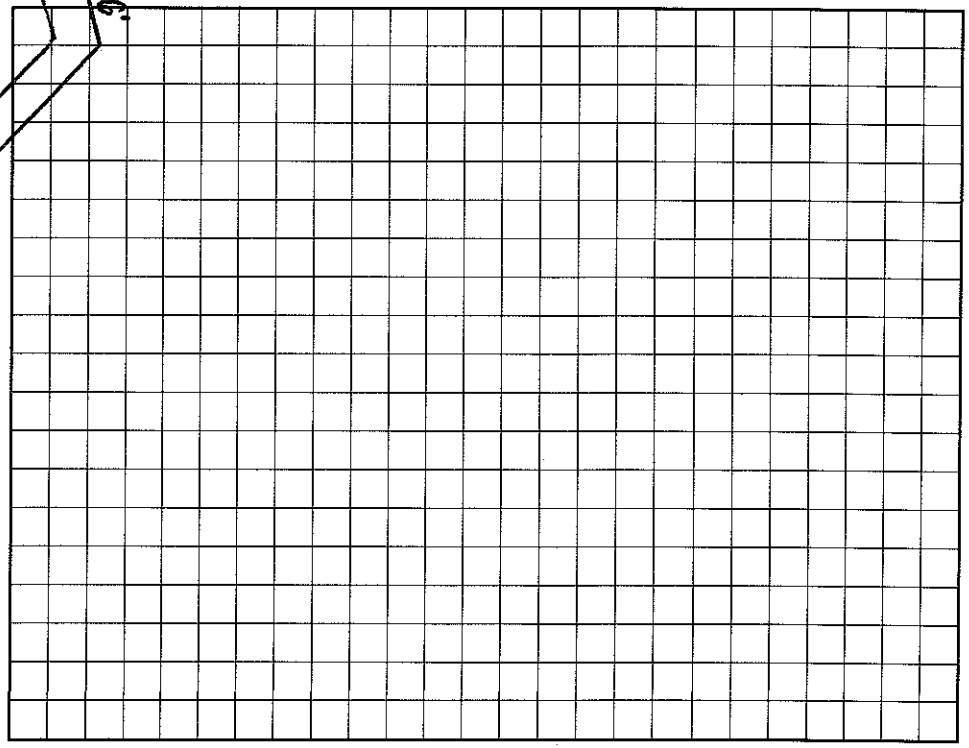

I understand that this permit can be suspended or revoked if any false information is supplied toward securing the permit/any unauthorized changes are made to the site/any unauthorized changes are made in the installation of the system. Improvement Permit with plat valid without expiration. Improvement Permit with site plan valid for sixty months. Authorization to Construct is valid for a period equal to that of Improvement Permit – not to exceed sixty months.

Signed: Torey C Gooch CPSS Agent date 10-15-98

Improvement Permit by: Mayfield Harrison RS date 9-15-98

Authorization to Construct by: Mayfield Harrison RS date 6-16-99

Installed by: R+H Const.

Operation Permit by: Wesley Sparks RS. date 1/5/01

Existing System Inspection by: date

HEALTH DEPT. COPY: WHITE INSPECTION COPY (FINAL): GREEN OWNER COPY (FINAL): YELLOW INSPECTION COPY (INITIAL): PINK OWNER COPY (INITIAL): GOLD