3:00

IREDELL COUNTY HEALTH DEPARTMENT

STATESVILLE 704-878-5305 , MOORESVILLE 704-664-5281

IMPROVEMENT PERMIT / AUTHORIZATION TO CONSTRUCT / OPERATION PERMIT / EXISTING SYSTEM INSPECTION

PERMIT # 175160 PIN # 4635162786 DATE 11-6-2012

OWNER or APPLICANT ES Johnson Builders LLC PHONE: Business 704 987-7950 Home Charlie McGarty 704 819 2193

OWNER or APPLICANT ADDRESS P.O. Box 1402 Cornelius NC 28031

LOCATION / DIRECTIONS Brawley School Rd TL Chatham TL Mayfair on right past Forestdale Ln (by walking Trail)

SUBDIVISION The Point BLOCK / SECTION 1-B LOT # 27 LOT AREA .79Ac DESIGN FLOW 440gpd L.T.A.R. .3

Septic Tank 1500 Gallons: STB 444 Date 3-2-13 ☒ New System ☐ Repair ☐ Expansion System Type I II III IV V VI

Pump Tank ___ Gallons: PT ___ Date ___ System Description: Gravity-Panel Block

Pump Make ___ Model ___ Serial # ___ Repair System Descrip LPP PBS 25% Red

Nitrification Field No Fields 1 No Lines 5 Linear Feet 335 500 Maintenance Agreement Required ☒ YES ☐ NO

Trench Width 24" min Max. Trench Bottom Depth 30-36" Gravel Depth N/A ☐ GRAVITY ☒ PRESSURE

☒ Residence No. Bedrooms 5 ☐ Business No. Persons ___ ☒ Other No. Employees ___ ☐ Slab ☒ Crawl Space ☐ Basement w/plumbing ☐ Basement w/o plumbing


Water Supply: ☐ Private ☒ Public ☒ Community

Comments / Conditions: * Follow specs outlined in Crescent Communities On Site Wastewater Manual.


Comments / Conditions: Note: Keep Septic System at least 15Ft from Roadcut

Tank & lines checked 4/9/13

INITIAL SITE SKETCH

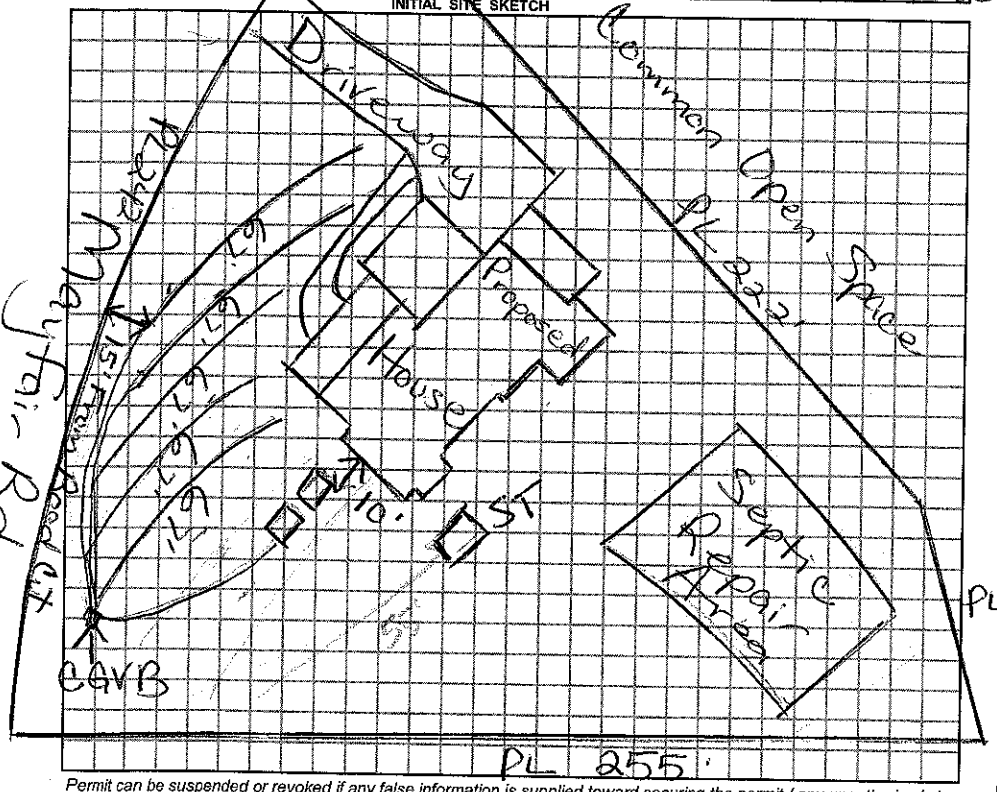

AS BUILT SKETCH

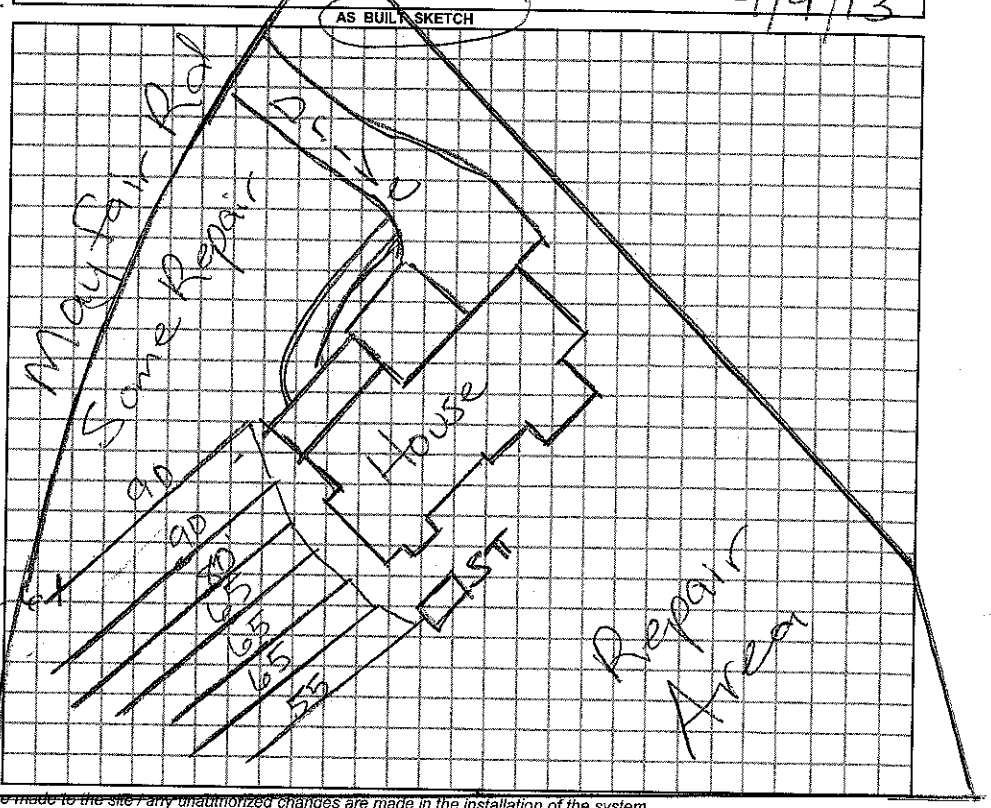

Permit can be suspended or revoked if any false information is supplied toward securing the permit / any unauthorized changes are made to the site / any unauthorized changes are made in the installation of the system.

☐ IMPROVEMENT PERMIT w / plat valid without expiration. ☒ IMPROVEMENT PERMIT w / site plan valid for 60 mos. ☐ AUTHORIZATION TO CONSTRUCT valid for period equal to IMPROVEMENT PERMIT-not to exceed 60 mo.

Owner / Applicant Signature: [signature] Date 11/7/12

Improvement Permit by: Maina Dolan RS Date 11/6/12

Authorization to Construct by: Maina Dolan RS Date 11/6/12

YOU SHOULD CONTACT A LOCATOR SERVICE PRIOR TO ANY EXCAVATION.

Installed by: Willie Christenbury & Lawing

Operation Permit by: Maina Dolan RS Date: 5/13/13

Existing System Inspected by: ___ Date: ___

WHITE COPY Environmental Health YELLOW COPY (Final) Owner / Applicant PINK COPY (Initial) Owner / Applicant