IREDELL COUNTY HEALTH DEPARTMENT

STATESVILLE 704-878-5305 MOORESVILLE 704-664-5281

IMPROVEMENT PERMIT / AUTHORIZATION TO CONSTRUCT / OPERATION PERMIT / EXISTING SYSTEM INSPECTION

PERMIT# 073896 PIN# 4625944634 (pt.) 4635-16-3543 DATE Sept. 16, 198

OWNER OR CONTRACTOR Crescent Resources Inc. PHONE: Business _____ Home _____

ADDRESS P.O. Box 1003, Charlotte

LOCATION Crawley Sch Rd. TL Chatham Rd. TL Mayfair Rd. TR Tisbury Ct. at end on Right

SUBDIVISION The Pointe BLOCK / SECTION 1-B LOT 29 LOT AREA 30,987 ft² SITE CLASS. 15 DESIGN FLOW 480 gpd L.T.A.R. .25-.3

Septic Tank: 1500+ Gallons; STB 797 Date 12/21/99

Pump Tank: 1000 Gallons; PT 29 Date 12/11/99

Pump Make: MYERS Model ME3 Serial No. 12/99

Nitrification Field: No Fields 1 Square Feet 1260 Linear Feet 420

No Lines 3 @ 140' Trench Width 36" Max Trench Bottom Depth 36" Gravel Depth NA

☑ New System ☐ Repair System Type: I, II, III, IV, V, VI

System Description: pumped pm - 25% Reduction

Repair System Description: SAME / LP Panel / BK

Maintenance Agreement Required: ☐ Yes ☒ No

☑ House/Mod. Home No. Bedrooms 4

☐ Mobile Home No. Bathrooms 4

☐ Business No. Employees ____

☐ Other ____


☑ Slab ☑ Crawl Space ☐ Basement w/plumbing ☐ Basement wo/plumbing

Water Supply: ☐ Individual ☒ Public ☐ Community


Comments:/Conditions: * ONE inspection port per LATERAL
7-14-99 Reviewed Site & grade plan - substantially in compliance w/ IP SRA

Comments:/Conditions: EZ LAY INSTALLED 1/14/00
Bush planted over S/T - Riser exposed -

INITIAL SITE SKETCH 1"=50'

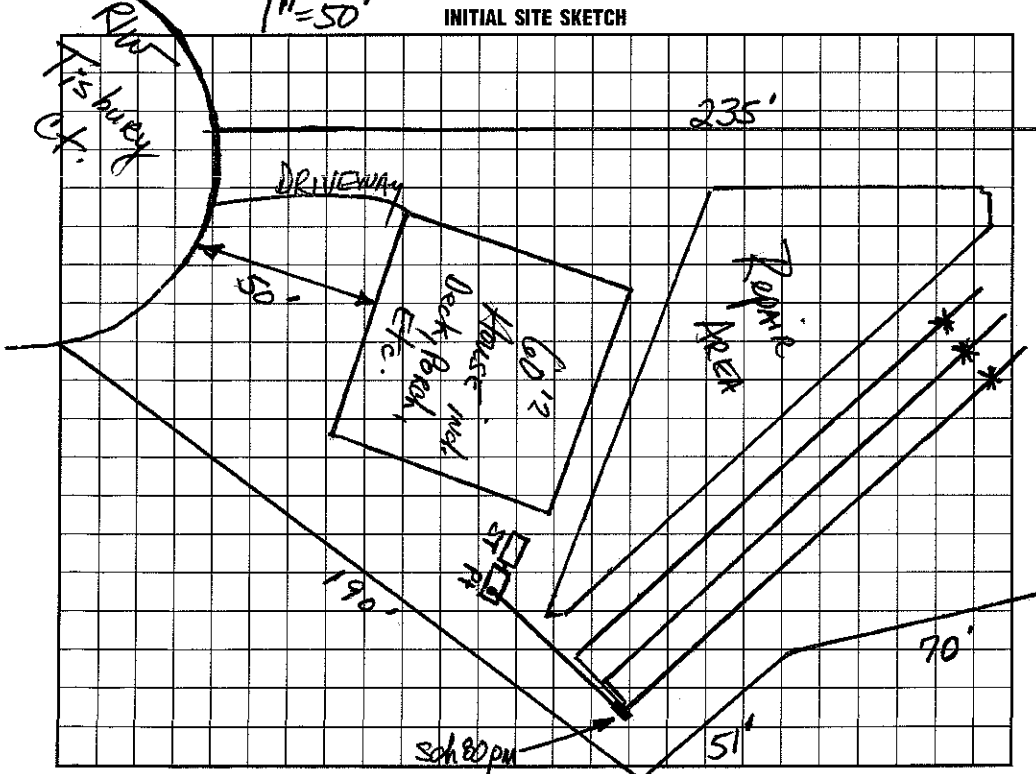

AS BUILT SKETCH

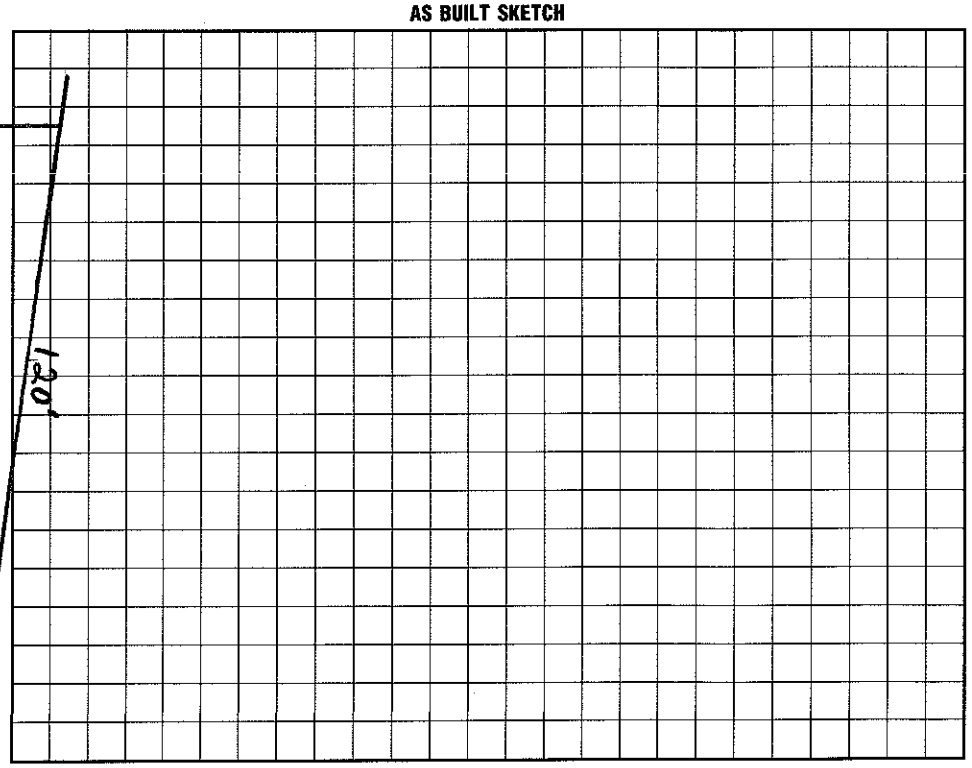

I understand that this permit can be suspended or revoked if any false information is supplied toward securing the permit/any unauthorized changes are made to the site/any unauthorized changes are made in the installation of the system. Improvement Permit with plat valid without expiration. Improvement Permit with site plan valid for sixty months. Authorization to Construct is valid for a period equal to that of Improvement Permit – not to exceed sixty months.

Signed: _____ date 10/15/98

Improvement Permit by: Marvin R. Hanson, RS date 9-16-98

Authorization to Construct by: Marvin R. Hanson, RS date 7-14-99

Installed by: Bob Mayhew

Operation Permit by: Wesley Sparks R.S. date 2/15/00

Existing System Inspection by: _____ date _____

HEALTH DEPT. COPY: WHITE INSPECTION COPY (FINAL): GREEN OWNER COPY (FINAL): YELLOW INSPECTION COPY (INITIAL): PINK OWNER COPY (INITIAL): GOLD