IREDELL COUNTY HEALTH DEPARTMENT

Statesville Office (704) 878-5305 Mooresville Office (704) 660-3625 PERMIT # BP 177986

IMPROVEMENT PERMIT / AUTHORIZATION TO CONSTRUCT / OPERATION PERMIT / EXISTING SYSTEM

PIN # 4635 16 4579

APPLICANT: Bob Hogan / Grainger APPLICANT ADDRESS: 420 Congress St Suite 170 Charlotte 28209

SITE ADDRESS: 200 Mayfair Rd Mooresville NC 28117 PHONE: ALT. PHONE:

SITE DIRECTIONS: Brawley School Rd, TL Chatham, TL Mayfair on right at corner of Tisbury Ct

SUBDIVISION: The Point SECTION: 1B LOT # 28 LOT AREA: .74 ac DESIGN FLOW: 480 gpd L.T.A.R.: 0.25 gpd/sq ft


Septic Tank	1500 (gal)	STB	338	Date	1-18-14	☒ New System	☐ Repair	☐ Expansion	System Type: I II III (IV) V VI
Pump Tank	1500 (gal)	PT	283	Date	12-30-13	System Description:	LP PPBPS		
Pump Make	Orenco	Model	Ord3804994	Serial #		Repair System Description:	LP PPBPS		
# Nitrification Fields	1	# Lines	5	Linear Ft:	320	Maintenance Agreement Required:	☒ YES	☐ NO	
Trench Width	36"	Max. Trench Bottom Depth	36"	Gravel Depth			☐ GRAVITY	☐ PRESSURE	

☒ Residence No. Bedrooms 4 — Water Supply
☐ Business No. Persons 8 — ☐ Private
☐ Other No. Employees — ☐ Public
☐ Slab ☒ Crawl Space — ☒ Community
☐ Basement w/plumbing ☐ Basement w/o plumbing

Comments / Conditions:

Tanks & drainlines Checked by HS on 3/27/14

INITIAL SITE SKETCH

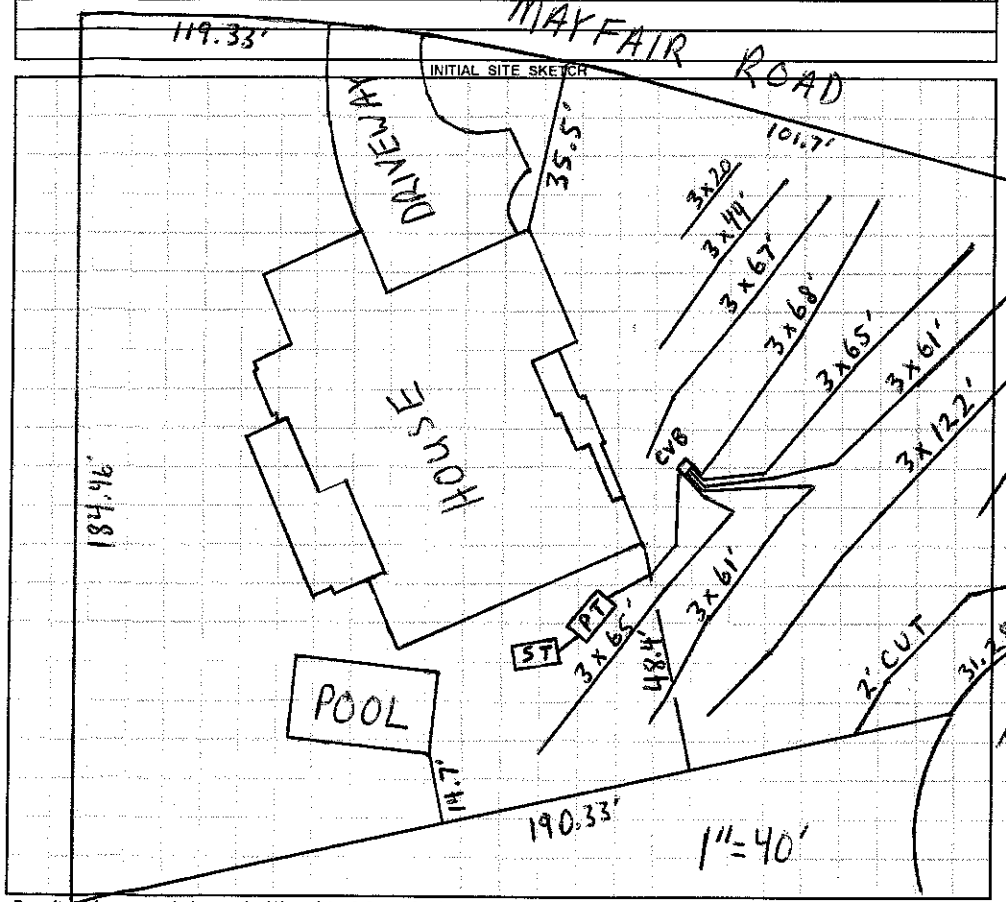

AS BUILT SKETCH

Permit can be suspended or revoked if any false information is supplied toward securing the permit / any unauthorized changes are made to the site / any unauthorized changes are made in the installation of the system. **CONTACT A LOCATOR SERVICE PRIOR TO ANY EXCAVATION**

☐ **IMPROVEMENT PERMIT** *with plat valid without expiration* ☒ **IMPROVEMENT PERMIT** *with site plan valid for 60 mos.* ☒ **AUTHORIZATION TO CONSTRUCT** *valid for period equal to IMPROVEMENT PERMIT--not to exceed 60 mo.*

Owner / Applicant Signature: Date: 9/25/13 Installed by: Richard Abernathy RS

IMPROVEMENT PERMIT by: Date: 9/25/13 OPERATION PERMIT by: Date: 6/24/14

AUTHORIZATION TO CONSTRUCT by: Date: 9/25/13 Existing System Inspected by: Date:

Health Dept. Copy - WHITE Applicant (Final Approval) - YELLOW Applicant (Conditional Approval) - PINK