IREDELL COUNTY HEALTH DEPARTMENT

STATESVILLE 704-878-5305 MOORESVILLE 704-664-5281

IMPROVEMENT PERMIT / AUTHORIZATION TO CONSTRUCT / OPERATION PERMIT / EXISTING SYSTEM INSPECTION

PERMIT# 073941 PIN# 4625944684 (pt.) 4635-16-5897 DATE Sept. 19, '98

OWNER OR CONTRACTOR Crescent Resources Inc. (Gerry Bates) PHONE: Business Home

ADDRESS P.O. Box 1003, Charlotte

LOCATION Brawley Sch. Rd. Tl. Chatham Rd. Tl. Mayfair Rd. on left before jct w/ Tisbury Ct.

SUBDIVISION The Pointe BLOCK / SECTION I-B LOT 41 LOT AREA 41,393 ft² SITE CLASS. PS DESIGN FLOW 480 gpd L.T.A.R. .3

Septic Tank: ~~1000~~ 1500 Gallons; STB 338 Date 2/29/00

Pump Tank: 1000 Gallons; PT 27 Date 4/8/00

Pump Make: ME-505-21 Model MYERS Serial No. 2100

Nitrification Field: No Fields 1 Square Feet 1200 Linear Feet 400

No Lines 4@100' Trench Width 36" Max Trench Bottom Depth 36" Gravel Depth NA

☑ New System ☐ Repair System Type: I, II, III, IV, V, VI

System Description: pumped pm - 25% Reduction

Repair System Description: LP Panel Block

Maintenance Agreement Required: ☐ Yes ☑ No

☑ House/Mod. Home No. Bedrooms 4

☐ Mobile Home No. Bathrooms 4

☐ Business No. Employees

☐ Other

☑ Slab ☑ Crawl Space ☑ Basement w/plumbing ☐ Basement wo/plumbing


Water Supply: ☐ Individual ☐ Public ☑ Community

Comments:/Conditions: *ONE INSPECTION port PER LATERAL. Remove any old burms, terraces.


6-10-99 Received house & site plan - substantially in compliance w/ IP ppt DPH

Comments:/Conditions: (partial) OK for full basement - DPH Driveway now to be on right side - install sleeve under drive for W.W. Supply line & Hug left lot line w/ water line installation DPH

INITIAL SITE SKETCH

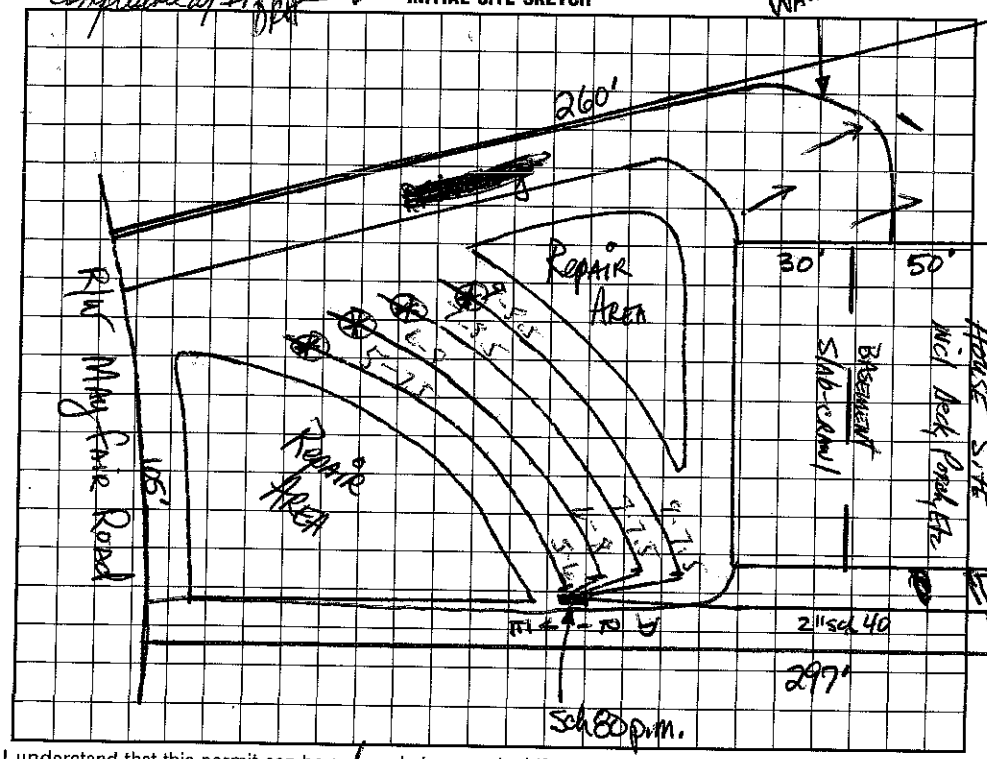

AS BUILT SKETCH

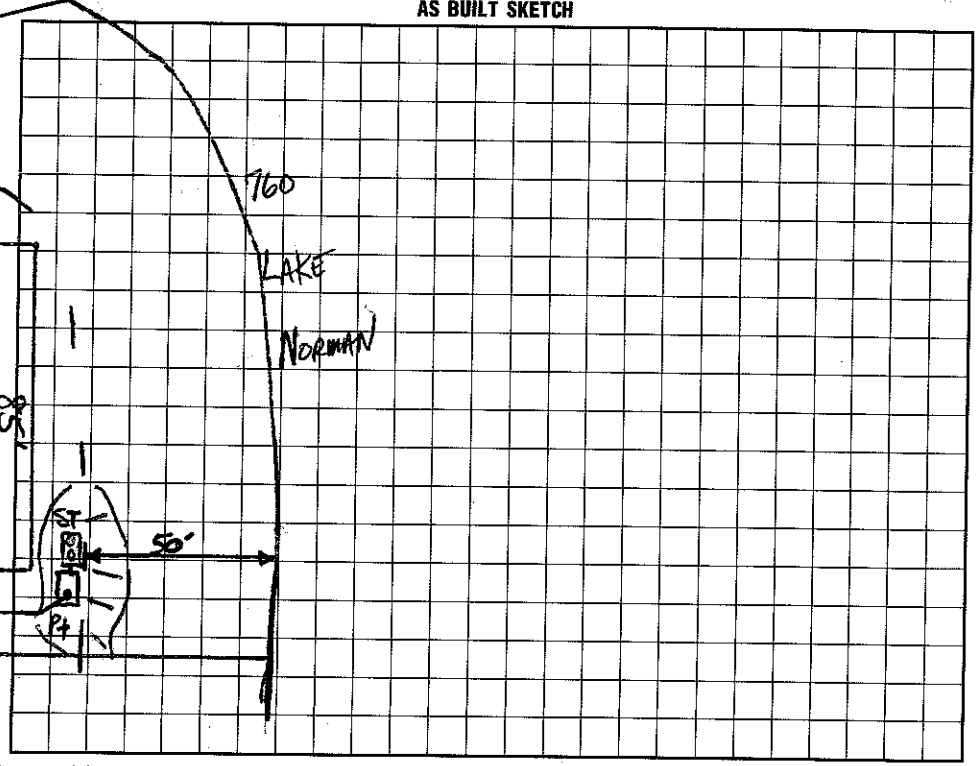

I understand that this permit can be suspended or revoked if any false information is supplied toward securing the permit/any unauthorized changes are made to the site/any unauthorized changes are made in the installation of the system. Improvement Permit with plat valid without expiration. Improvement Permit with site plan valid for sixty months. Authorization to Construct is valid for a period equal to that of Improvement Permit – not to exceed sixty months.

Signed: date 10/15/98

Improvement Permit by: Wayne L. Hamm RS date 9-19-98

Authorization to Construct by: Wayne L. Hamm RS date 6-10-99

Installed by: Orbison Constr.

Operation Permit by: Wesley Sparks R.S. date 10/17/00

Existing System Inspection by: date

HEALTH DEPT. COPY: WHITE INSPECTION COPY (FINAL): GREEN OWNER COPY (FINAL): YELLOW INSPECTION COPY (INITIAL): PINK OWNER COPY (INITIAL): GOLD