# IREDELL COUNTY HEALTH DEPARTMENT (MARK MISSLER) STATESVILLE 704-878-5305 MOORESVILLE 704-664-5281

## IMPROVEMENT PERMIT / AUTHORIZATION TO CONSTRUCT / OPERATION PERMIT / EXISTING SYSTEM INSPE... O...

PERMIT# 073934 PIN# ~~4729416684~~ 4635-16-6149 DATE Jan. 4, '99

OWNER OR CONTRACTOR Crescent Resources dba // John R. Pierce Builders PHONE: Business _____ Home _____

ADDRESS P.O. Box 1003, Charlotte

LOCATION Brawley School Rd. TL Chatham Rd. TL Mayfair Rd ON Right at end

SUBDIVISION The Pointe BLOCK / SECTION 1-B LOT 33 LOT AREA 34945 ± SITE CLASS. PS DESIGN FLOW 480 gpd L.T.A.R. no. 3

Septic Tank: 1000 Gallons; STB 338 Date 4/16/00
Pump Tank: 1000 Gallons; PT 37 Date 4/18/00
Pump Make: MYERS Model ME-503-21 Serial No. 2532-5D69
Nitrification Field: No Fields 1 Square Feet 810 Linear Feet 270
No Lines 3@90' Trench Width 36" Max Trench Bottom Depth ~30" Gravel Depth NA

☑ New System ☐ Repair System Type: I, II, III, IV, V, VI
System Description: LP Panel Block
Repair System Description: Same
Maintenance Agreement Required: ☑ Yes ☐ No

☑ House/Mod. Home No. Bedrooms 4
☐ Mobile Home No. Bathrooms 4
☐ Business No. Employees ____
☐ Other ____
☑ Slab ☑ Crawl Space ☐ Basement w/plumbing ☐ Basement wo/plumbing

Water Supply: ☐ Individual ☑ Public ☐ Community


Comments:/Conditions:

Comments:/Conditions: Jan 4, '99 - House & Site plan reviewed; appears in compliance w/ IP 88K


Tanks, Pump, Pressure, Drainlines 6/8/00

1" = 50'

INITIAL SITE SKETCH

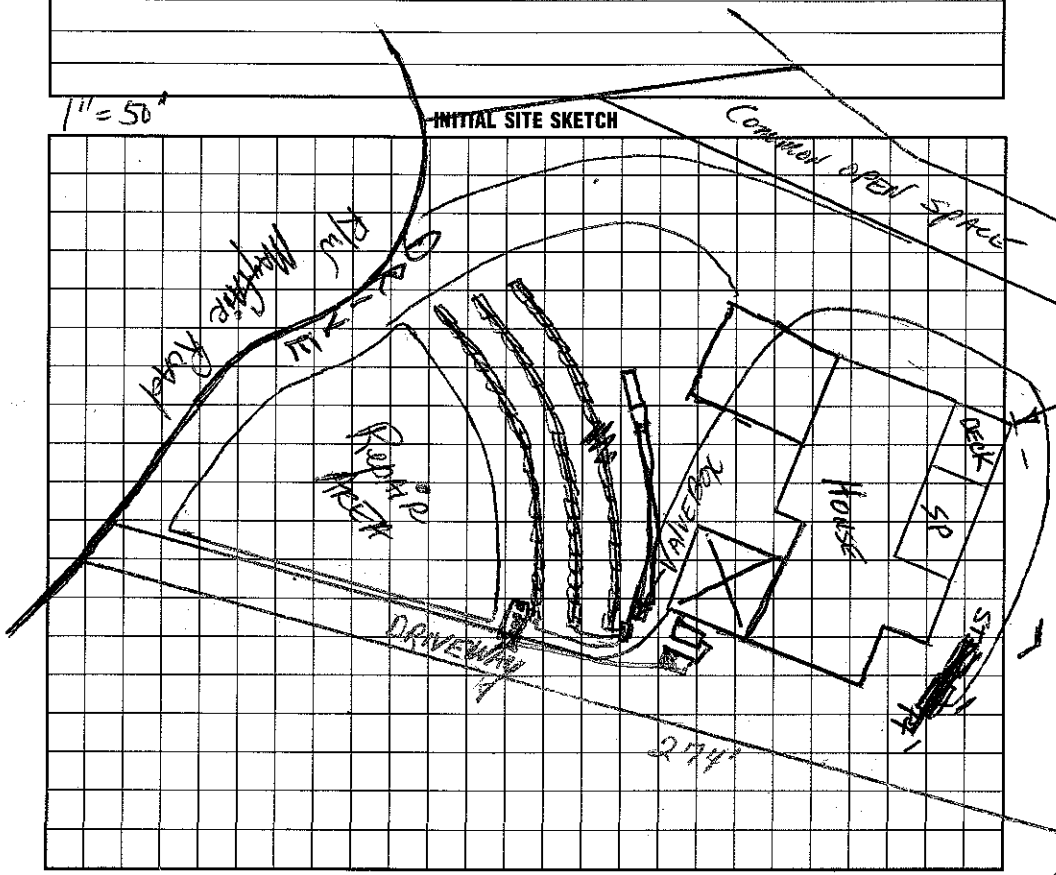


AS BUILT SKETCH

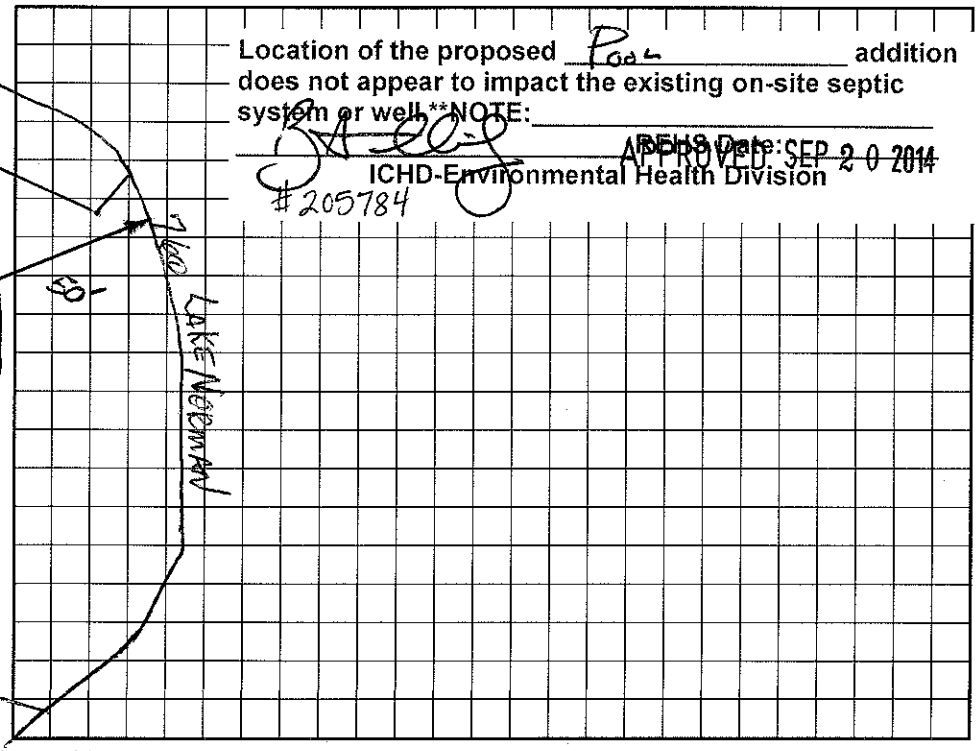


Location of the proposed Pool addition does not appear to impact the existing on-site septic system or well.**NOTE:

APPROVED SEP 20 2014
ICHD-Environmental Health Division
#205784

I understand that this permit can be suspended or revoked if any false information is supplied toward securing the permit/any unauthorized changes are made to the site/any unauthorized changes are made in the installation of the system. Improvement Permit with plat valid without expiration. Improvement Permit with site plan valid for sixty months. Authorization to Construct is valid for a period equal to that of Improvement Permit – not to exceed sixty months.

Signed: Marvin O. Crouse date ____

Improvement Permit by: [signature] RS date 1-4-99

Authorization to Construct by: [signature] RS date 1-4-99

Installed by: Stanley Septic Service

Operation Permit by: Wesley Sparks RS date 7/13/00

Existing System Inspection by: ____ date ____

HEALTH DEPT. COPY: WHITE INSPECTION COPY (FINAL): GREEN OWNER COPY (FINAL): YELLOW INSPECTION COPY (INITIAL): PINK OWNER COPY (INITIAL): GOLD