IREDELL COUNTY HEALTH DEPARTMENT

STATESVILLE 704-878-5305 MOORESVILLE 704-664-5281

IMPROVEMENT PERMIT / AUTHORIZATION TO CONSTRUCT / OPERATION PERMIT / EXISTING SYSTEM INSPECTION

2100

PERMIT# 073940 PIN# 4625944684 (pt) Darrell 4635-16-6786 DATE Sept. 19, 98

OWNER OR CONTRACTOR Crescent Resources Inc. / Dienst PHONE: Business 201-0264 Home

ADDRESS P.O. Box 1003 Charlotte

LOCATION Brawley Sch. Rd. TL Chatham Rd. TL Mayfair Rd on left before jct w/ Tisbury Ct.

SUBDIVISION The Pointe BLOCK / SECTION 1-B LOT 40 LOT AREA 41,378 ft² SITE CLASS. PS DESIGN FLOW 440gpd L.T.A.R. ~.3

Septic Tank: ~~1000~~ 1500 Gallons; STB 338 Date 11-13-00

Pump Tank: 1000 Gallons; PT 283 Date 12-5-00

Pump Make: Model Serial No.

Nitrification Field: No Fields 1 Square Feet 870 Linear Feet 290

No Lines 4 Trench Width 36" Max Trench Bottom Depth 30" Gravel Depth N/A

☑ New System ☐ Repair System Type: I, II, III, (IV) V, VI

System Description: LP Panel Block

Repair System Description: SAME

Maintenance Agreement Required: ☑ Yes ☐ No

☑ House/Mod. Home No. Bedrooms 4

☐ Mobile Home No. Bathrooms 4

☐ Business No. Employees

☐ Other

☑ Slab ☐ Crawl Space ☑ Basement w/plumbing ☐ Basement wo/plumbing


Water Supply: ☐ Individual ☑ Public ☑ Community

Comments:/Conditions:


Comments:/Conditions: (PARTIAL)
Lines Checked 11/1/2000 MD
Filter & riser
Driveway on other side of lot; Supply line on other side
X See Attached

1"=50'

INITIAL SITE SKETCH

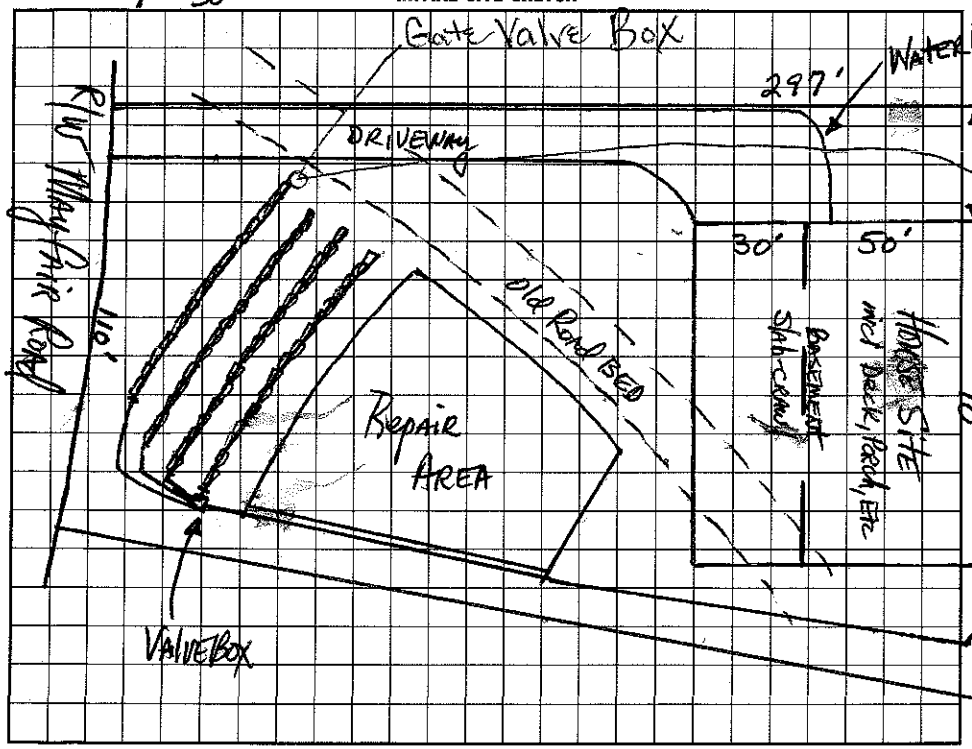

AS BUILT SKETCH

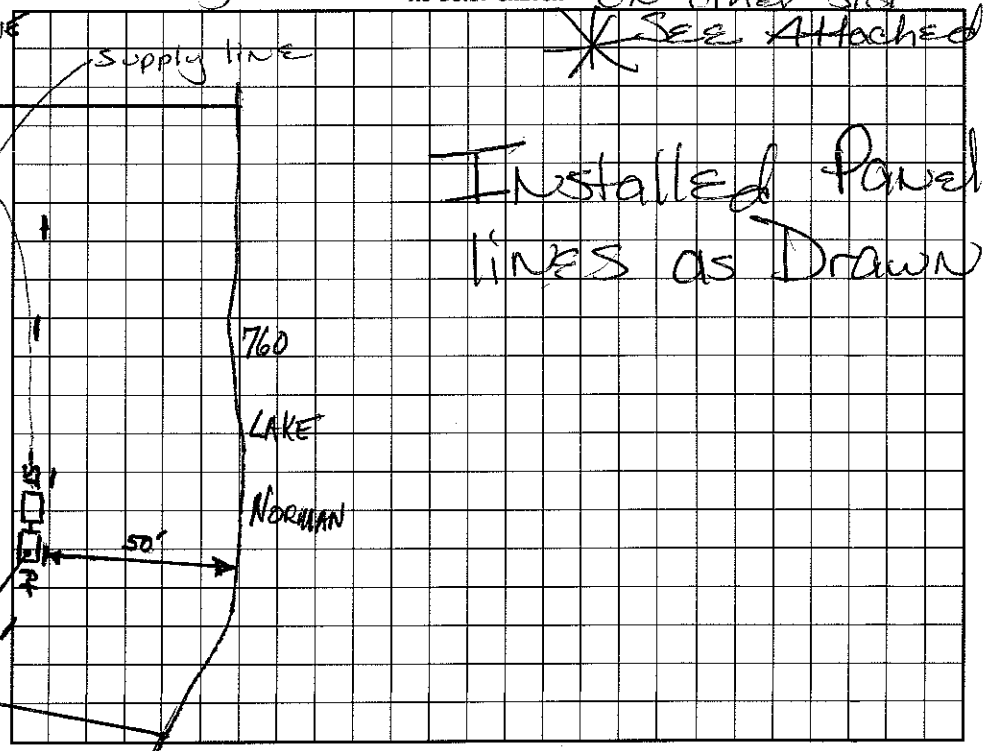

Installed Panel lines as Drawn

I understand that this permit can be suspended or revoked if any false information is supplied toward securing the permit/any unauthorized changes are made to the site/any unauthorized changes are made in the installation of the system. Improvement Permit with plat valid without expiration. Improvement Permit with site plan valid for sixty months. Authorization to Construct is valid for a period equal to that of Improvement Permit – not to exceed sixty months.

Signed: date 10/15/98 Installed by: R & H

Improvement Permit by: date 9-19-98 Operation Permit by: date 12/1/2000

Authorization to Construct by: Wesley Sparks R.S. date 9/11/00 Existing System Inspection by: date

HEALTH DEPT. COPY: WHITE INSPECTION COPY (FINAL): GREEN OWNER COPY (FINAL): YELLOW INSPECTION COPY (INITIAL): PINK OWNER COPY (INITIAL): GOLD