IREDELL COUNTY HEALTH DEPARTMENT

STATESVILLE 704-878-5305 ∅ MOORESVILLE 704-664-5281

IMPROVEMENT PERMIT / AUTHORIZATION TO CONSTRUCT / OPERATION PERMIT / EXISTING SYSTEM INSPECTION

PERMIT# 073939 / 116097 PIN# ~~4625 99 1684 AF~~ 4635-16-7623 DATE 9/23/04

OWNER OR CONTRACTOR David Dibble Custom Homes PHONE: Business 704-799-1688 Home

ADDRESS PO Box 4717 Mooresville NC 28117

LOCATION BSR, TL Chatham, TL Mayfair, on lt across from Tisbury Ct.

SUBDIVISION The Point BLOCK / SECTION 1-B LOT 39 LOT AREA 35,496 Ft² SITE CLASS. PS DESIGN FLOW 480 L.T.A.R. 0.3

Septic Tank: ~~1000~~ 1500 Gallons; STB 33% Date 9/8/04

Pump Tank: 1000 Gallons; PT 27 Date 9/11/04

Pump Make: Goulds Model WE07J1HP4 Serial No.

Nitrification Field: No Fields 1 Square Feet 900 Linear Feet 300

No Lines 4 Trench Width 36" Max Trench Bottom Depth 36" Gravel Depth —

☒ New System ☐ Repair System Type: I, II, III, (IV), V, VI

System Description: LP Panel Block

Repair System Description: Same

Maintenance Agreement Required: ☒ Yes ☐ No

☒ House/Mod. Home No. Bedrooms 4

☐ Mobile Home No. Bathrooms

☐ Business No. Employees

☐ Other

☒ Slab ☐ Crawl Space ☒ Basement w/plumbing ☐ Basement wo/plumbing


Water Supply: ☐ Individual ☐ Public ☒ ~~Community~~

Comments:/Conditions:


1" = 50'

Comments:/Conditions:

INITIAL SITE SKETCH

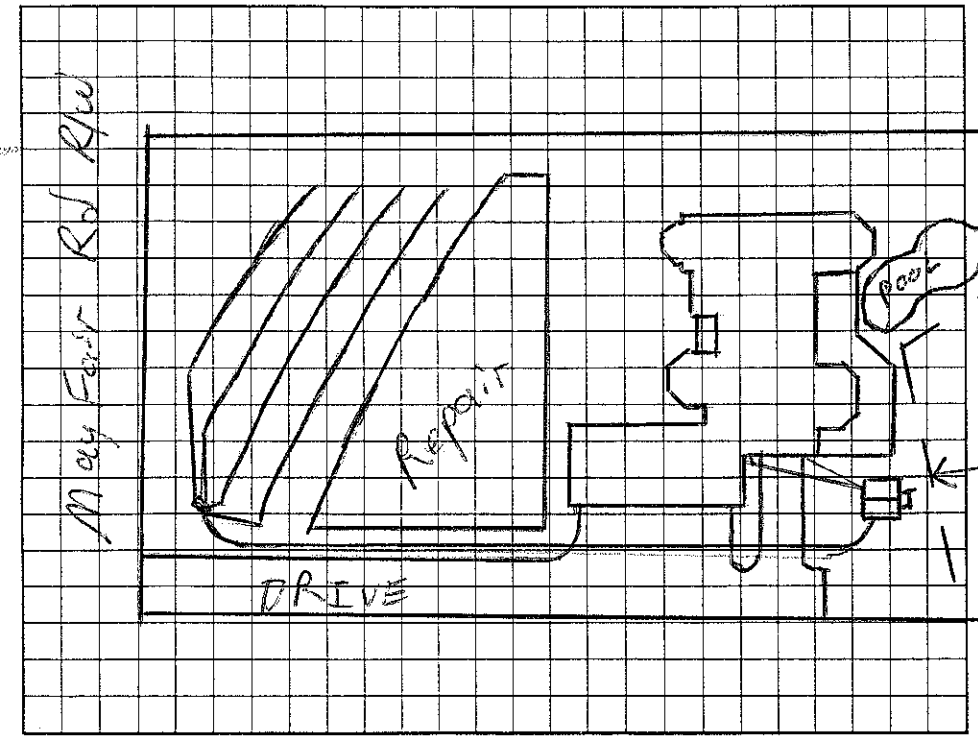

AS BUILT SKETCH

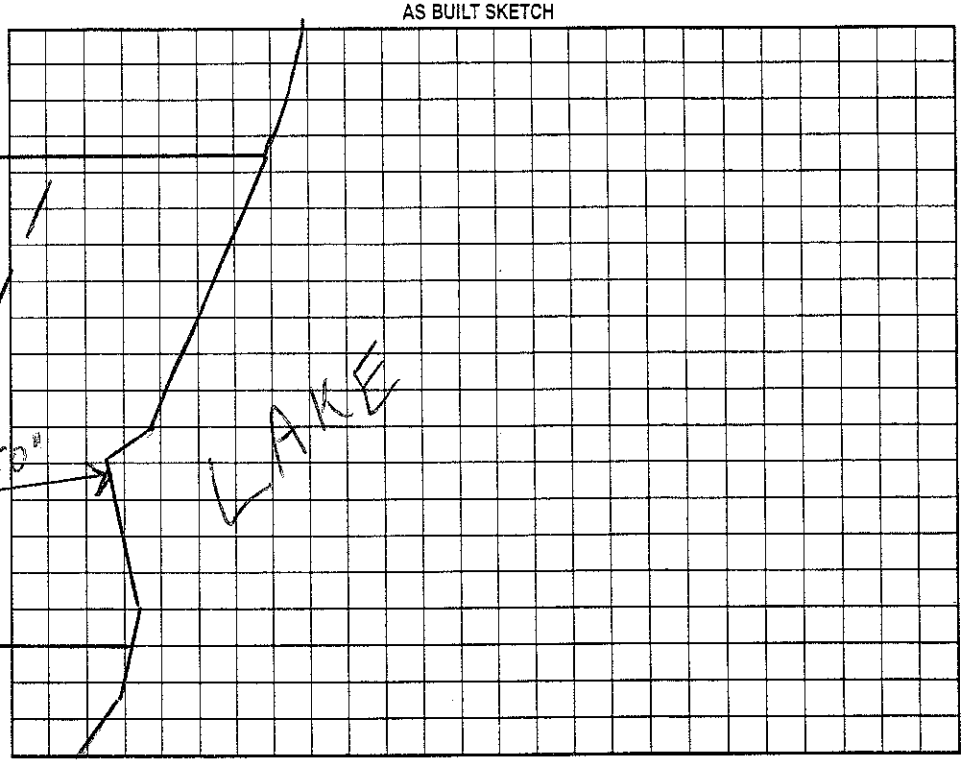

Permit can be suspended or revoked if any false information is supplied toward securing the permit/any unauthorized changes are made to the site/any unauthorized changes are made in the installation of the system. Improvement Permit with plat valid without expiration. Improvement Permit with site plan valid for sixty months. Authorization to Construct is valid for a period equal to that of Improvement Permit – not to exceed sixty months.

Signed: [signature] date 9/27/04 Installed by: Orbison

Improvement Permit by: [signature] RS date 9/23/04 Operation Permit by: [signature] RS date 10/28/04

Authorization to Construct by: [signature] RS date 9/23/04 Existing System Inspection by: date

HEALTH DEPT. COPY: WHITE OWNER COPY (FINAL): YELLOW OWNER COPY (INITIAL): PINK