IREDELL COUNTY HEALTH DEPARTMENT

Statesville Office (704) 878-5305 Mooresville Office (704) 660-3625 PERMIT # 208909

IMPROVEMENT PERMIT / AUTHORIZATION TO CONSTRUCT / OPERATION PERMIT / EXISTING SYSTEM

PIN # 4635168430

APPLICANT: OVERSTREAM INC APPLICANT ADDRESS: PO BOX 1215 MATTHEWS NC 28106

SITE ADDRESS: 219 MAYFAIR RD. MOORESVILLE NC 28117 PHONE: ALT. PHONE: 704 236 5836

SITE DIRECTIONS: BRAWLEY SCHOOL RD - TL CHEEHAM RD - TL MAYFAIR - ON LT AT END

SUBDIVISION: The POINT on Norman SECTION: 1B LOT # 37 LOT AREA: 36,820 ft² DESIGN FLOW: 480 L.T.A.R.: .3

Septic Tank ____ (gal) STB ____ Date ____

Pump Tank ____ (gal) PT EXISTING Date ____

Pump Make ____ Model ____ Serial # ____

Nitrification Fields ____ # Lines ____ Linear Ft: ____

Trench Width ____ Max. Trench Bottom Depth ____ Gravel Depth ____

☐ New System ☐ Repair ☐ Expansion System Type: I II III ☑ IV V VI

System Description: PUMP UPGRADE

Repair System Description: SAME

Maintenance Agreement Required: ☑ YES ☐ NO

☐ GRAVITY ☑ PRESSURE

☑ Residence No. Bedrooms 4

☐ Business No. Persons 8

☐ Other No. Employees

☐ Slab ☑ Crawl Space

☑ Basement w/plumbing ☐ Basement w/o plumbing

Water Supply: ☐ Private ☐ Public ☑ Community

Comments / Conditions: KEEP POOL 19' FROM TANKS

INITIAL SITE SKETCH

SEE KENNY OWEN LSS' DESIGN

AS BUILT SKETCH

Permit can be suspended or revoked if any false information is supplied toward securing the permit / any unauthorized changes are made to the site / any unauthorized changes are made in the installation of the system. **CONTACT A LOCATOR SERVICE PRIOR TO ANY EXCAVATION**

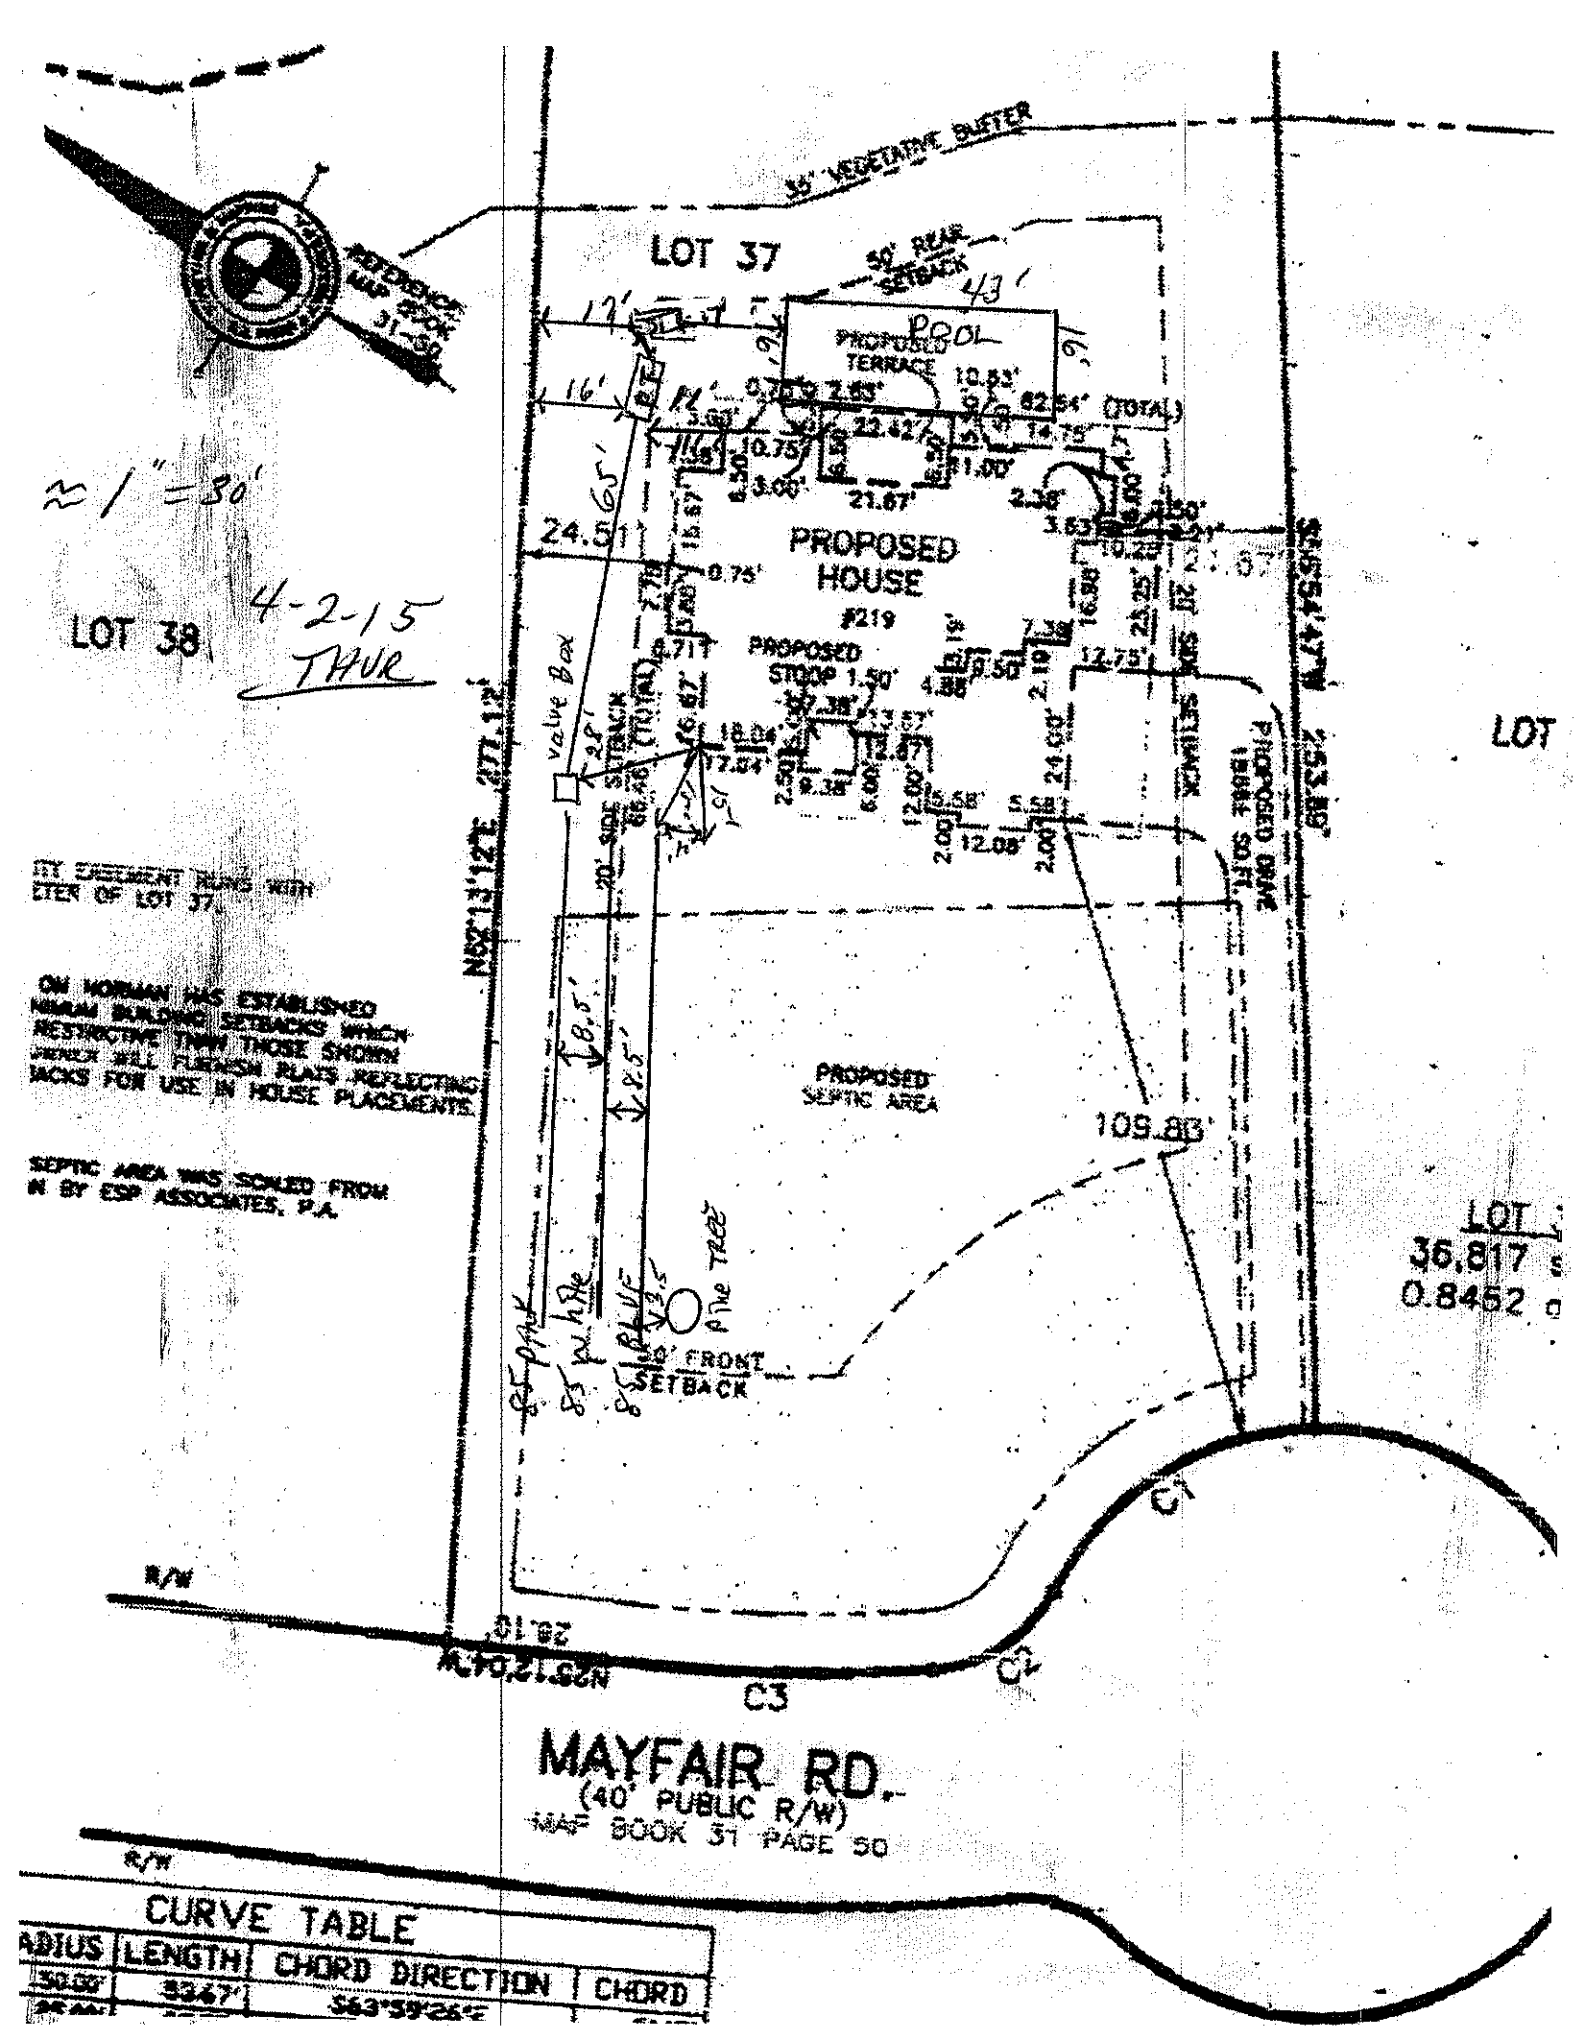
☐ **IMPROVEMENT PERMIT** *with plat valid without expiration.* ☐ **IMPROVEMENT PERMIT** *with site plan valid for 60 mos.* ☐ **AUTHORIZATION TO CONSTRUCT** *valid for period equal to IMPROVEMENT PERMIT--not to exceed 60 mo.*

Owner / Applicant Signature: [signature] Date: 4-14-15 Installed by:

IMPROVEMENT PERMIT by: Date: OPERATION PERMIT by: Date:

AUTHORIZATION TO CONSTRUCT by: Date: Existing System Inspected by: [signature] Date: 4/10/15

Health Dept. Copy - WHITE Applicant (Final Approval) - YELLOW Applicant (Conditional Approval) - PINK


LOT 37
LOT 38
4-2-15
THUR
≈ 1"=30'
35' VEGETATIVE BUFFER
50' REAR SETBACK
43'
POOL
PROPOSED TERRACE
PROPOSED HOUSE
#219
PROPOSED STOOP 1.50'
PROPOSED SEPTIC AREA
109.83'
Valve Box
N62°13'12"E 277.12'
S53°54'47"E 253.89'
LOT
36,817 s
0.8452 a
20' SIDE SETBACK
40' FRONT SETBACK
Pine Tree
R/W
C1
C2
C3
MAYFAIR RD.
(40' PUBLIC R/W)
MAP BOOK 31 PAGE 50
CURVE TABLE
RADIUS
LENGTH
CHORD DIRECTION
CHORD