IREDELL COUNTY HEALTH DEPARTMENT

STATESVILLE 704-878-5305 MOORESVILLE 704-664-5281

IMPROVEMENT PERMIT / AUTHORIZATION TO CONSTRUCT / OPERATION PERMIT / EXISTING SYSTEM INSPECTION

12,448.2

PERMIT# 01500312448.2 PIN# 4625944684 4635-17-0985 DATE 9-24-04

OWNER OR CONTRACTOR John R Poore PHONE: Business Home

ADDRESS 105 Independence Pt Pkwy Ste 100 Matthews, NC

LOCATION Brawley School Rd TL Quaker Rd on left at end

SUBDIVISION The Point BLOCK / SECTION 1-C LOT 16 LOT AREA 39,514 SITE CLASS. PS DESIGN FLOW 600gpd L.T.A.R. 0.25

Septic Tank: 1500 Gallons: STB 338 Date 9-13-05

Pump Tank: 1500 Gallons: PT 283 Date 9-13-05

Pump Make: Myers Model Serial No.

Nitrification Field: No Fields 1 Square Feet 1200' Linear Feet 400'

No Lines 5 Trench Width 24"-36" Max Trench Bottom Depth 30-36" Gravel Depth N/A

☒ New System ☐ Repair System Type: I, II, III, IV, V, VI

System Description: LP-Panel Block

Repair System Description: Same

Maintenance Agreement Required: ☒ Yes ☐ No

☒ House/Mod. Home ☐ Mobile Home ☐ Business ☐ Other

No. Bedrooms 5 No. Bathrooms 7 No. Employees

☐ Slab ☐ Crawl Space ☒ Basement w/plumbing ☐ Basement wo/plumbing

Water Supply: ☐ Individual ☒ Public ☒ Community


Comments:/Conditions:

Comments:/Conditions: check tanks & lines 10/18/05


11/4/04 Elect & alarm

~24FF

INITIAL SITE SKETCH Scale 1:50

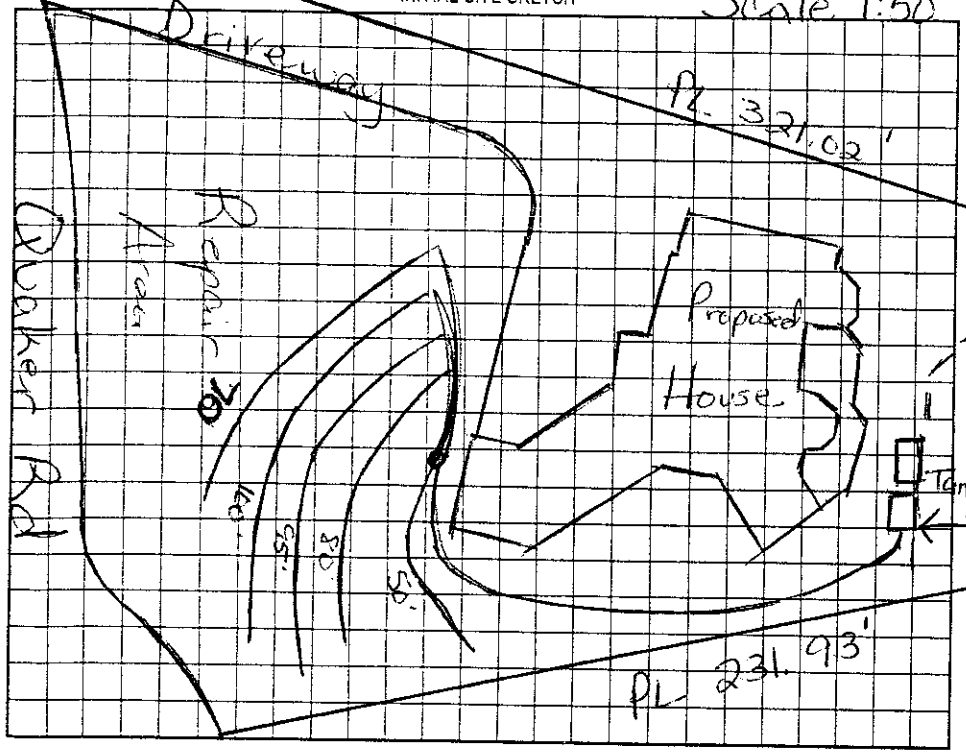

AS BUILT SKETCH

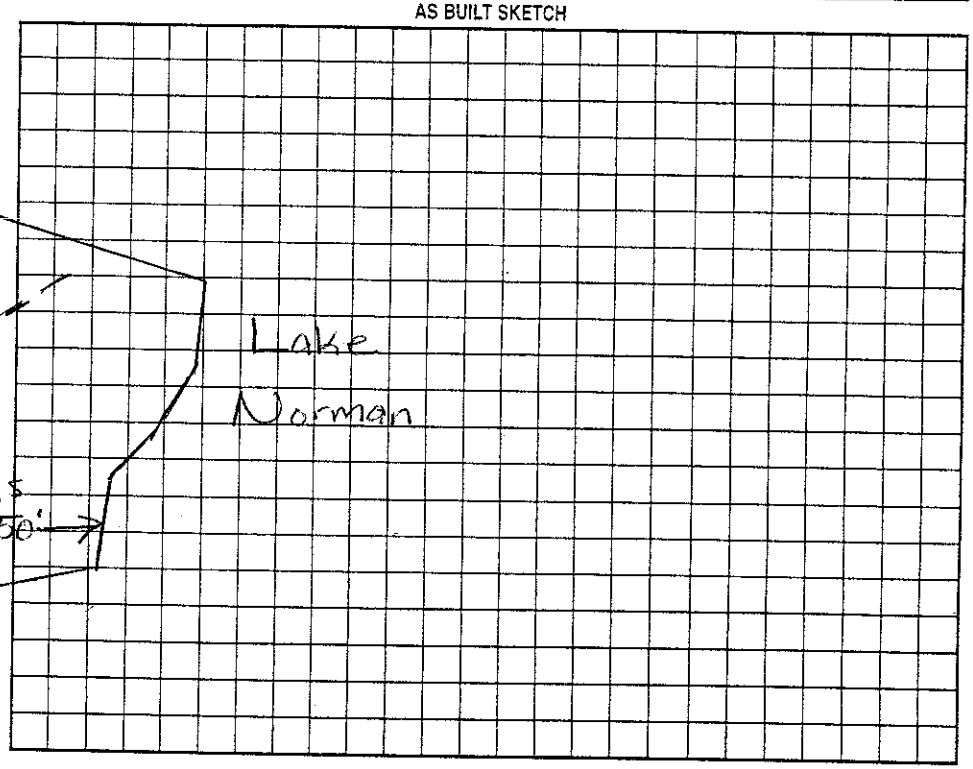

Permit can be suspended or revoked if any false information is supplied toward securing the permit/any unauthorized changes are made to the site/any unauthorized changes are made in the installation of the system. Improvement Permit with plat valid without expiration. Improvement Permit with site plan valid for sixty months. Authorization to Construct is valid for a period equal to that of Improvement Permit – not to exceed sixty months.

Signed: date

Improvement Permit by: Maria H Dotson RS date 9/28/04

Authorization to Construct by: Maria H Dotson RS date 9/28/04

Installed by: R & H RS

Operation Permit by: Maria H Dotson RS date 11/4/05

Existing System Inspection by: date

HEALTH DEPT. COPY: WHITE OWNER COPY (FINAL): YELLOW OWNER COPY (INITIAL): PINK