IREDELL COUNTY HEALTH DEPARTMENT

STATESVILLE 704-878-5305 MOORESVILLE 704-664-5281

IMPROVEMENT PERMIT / AUTHORIZATION TO CONSTRUCT / OPERATION PERMIT / EXISTING SYSTEM INSPECTION

PERMIT# 144521 PIN# 4635 17 1666 DATE 8/10/07

OWNER OR APPLICANT Charles Farar PHONE: Business 973-617-4562 Home

ADDRESS 6 Jubilee Way Randolph, NJ. 07869

LOCATION 210 QUAKER RD. - 1100 Ft Check Rd to end (Cul de sac) straight off cul de sac

SUBDIVISION Point BLOCK / SECTION 1-C LOT 13/13A LOT AREA 58,147 + 15,216 SITE CLASS. PS DESIGN FLOW 600 L.T.A.R. 435FE 13A

Septic Tank: 1500 Gallons; STB 338 Date 11-29-07

Pump Tank: 1500 Gallons; PT 477 Date 12-12-08

Pump Make: Myers Model F102ME150 Serial No.

Nitrification Field: No Fields 1 Square Feet 999 Linear Feet 333

No Lines 4@84' Trench Width 2-3' Max Trench Bottom Depth 3' Gravel Depth No

☒ New System ☐ Repair ☐ Expansion System Type: I II III IV V VI

System Description: Pres Dosed -16" PPBAS

Repair System Description: Same Type

Maintenance Agreement Required: ☒ Yes ☐ No

☒ House/Mod. Home ☐ Mobile Home ☐ Business ☐ Other

No. Bedrooms 5 No. Persons 10 No. Employees


Water Supply: ☐ Individual ☐ Public ☒ Community POINT

☐ Gravity ☒ Pressure ☐ Slab ☐ Crawl Space ☒ Basement w/plumbing ☐ Basement wo/plumbing

Comments/Conditions: Remove old berm and terraces in 5FE13A; Central Valve Box just above highest drainline.

(1"=100')


INITIAL SITE SKETCH

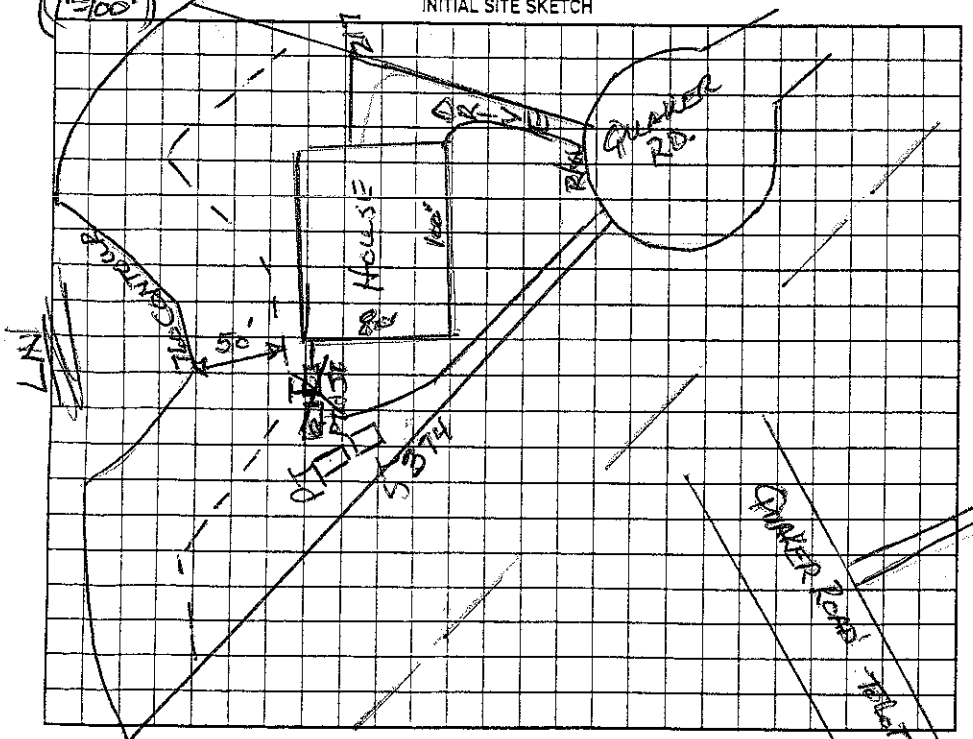

Comments/Conditions: 8-13-08 CONTACTED KEN WRENCH TO INFORM HIM THAT TANKS MUST BE 15' FROM RETAINING WALL 5' POOL - HE WILL INFORM ENGINEER (CJH) 3/16" hole drilled. Checked lines 7/10/09

AS BUILT SKETCH

As Built attached. (for Drainfield Tanks Checked 11/19/10 MB)

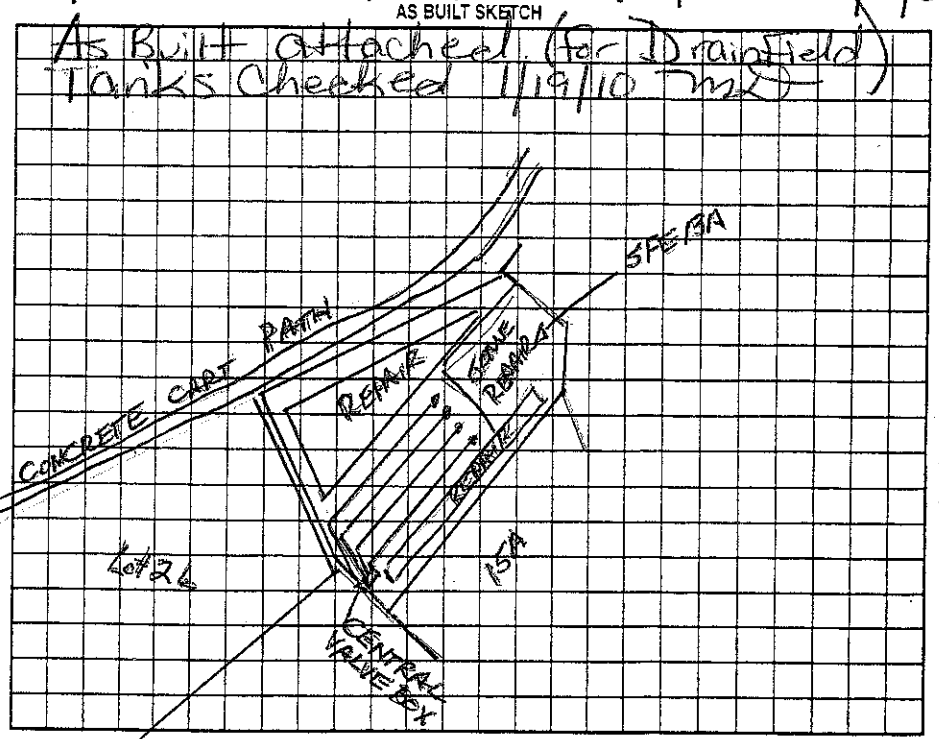

Permit can be suspended or revoked if any false information is supplied toward securing the permit/any unauthorized changes are made to the site/any unauthorized changes are made in the installation of the system. Improvement Permit with plat valid without expiration ☐ Improvement Permit with site plan valid for sixty months ☒ Authorization to Construct is valid for a period equal to that of Improvement Permit – not to exceed sixty months.

Signed: *Michele M. Burton date 8-17-07

Improvement Permit by: Wesley Sparks R.S. date 8/10/07

Authorization to Construct by: [signature] R.S. date 8-11-08

Installed by: R & H

Operation Permit by: [signature] date 3/19/2010

Existing System Inspection by: date

HEALTH DEPT. COPY: WHITE OWNER COPY (FINAL): YELLOW OWNER COPY (INITIAL): PINK