ENVIRONMENTAL HEALTH REQUIREMENTS

The following numbered items MUST BE COMPLETED PRIOR TO THE SUBMITTAL of the Improvement Permit (IP) / Authorization to Construct (AC) / Existing System application packet. **Questions? Call Iredell County Environmental Health between 8:00-9:00a.m., Monday-Friday to speak with a Registered Sanitarian.**
Statesville Office (704)878-5305 Mooresville Office (704)664-5281

---

1. **Complete all Environmental Health forms**: septic system application, site plan, new well water application (if applicable), and sign this green sheet **after** you completed all items. **Include in submittal a copy of the Zoning Permit.** A Zoning Permit is not required for septic system repairs or expansion where no addition is being made to an existing structure.

2. Clearly **mark all property corners**. Flag side lines every twenty-five feet if rear corners are not visible when standing on front corners.

3. **Stake or flag the footprint of the building structure**.

4. Where an **Authorization to Construct (AC) is desired**, submit a recorded copy of the **plat for the subdivision lot** (if not already on file at Environmental Health) and **include two(2) legible copies of the basic floor plan** not larger than 11" x 17" for each floor in the structure.

5. **Any site not having adequate visibility**(50' in any direction) **must be cleared of "undergrowth"** to allow access and provide good visibility.

6. All completed paperwork must be submitted to the Environmental Health Division of the Iredell County Health Department for review before any name will be placed on the service request (appointment) list. **Only properly completed applications will be placed on the service request list on a first come, first serve basis. Incomplete applications will be returned to the applicant.**

Completed permits must be picked up promptly. If it becomes necessary to send a certified letter (return receipt), postage will be charged and **any permit not picked up by the deadline in the letter will be voided. All monies paid to that point are non-refundable.**

Any site not ready when staff arrive for the evaluation will result in the applicant being charged a site revisit fee and the request being returned to the bottom of the service request list.

By signing below I am acknowledging the above specifications have been met and the site is ready to be evaluated.

Signature _____ **Date** 16 APR 14

IREDELL COUNTY HEALTH DEPARTMENT

STATESVILLE 704-878-5305 MOORESVILLE 704-664-5281

IMPROVEMENT PERMIT / AUTHORIZATION TO CONSTRUCT / OPERATION PERMIT / EXISTING SYSTEM INSPECTION

PERMIT# 14452I PIN# 4635 17 1666 DATE 8/16/07

OWNER OR APPLICANT Charles Farar PHONE: Business 973-617-4562 Home

ADDRESS 6 Julie Ann Way Randolph, NJ. 07869

LOCATION 219 OBAKEN RD. - 1/100 Ti Chestnut Ridge trail (Cul de sac) straight off on Dogwood

SUBDIVISION Point BLOCK / SECTION 1-C LOT 13/13A LOT AREA 58,147 + 15,246 SFE SITE CLASS. PS DESIGN FLOW 600 L.T.A.R. .35 FE 13A

Septic Tank: 1500 Gallons: STB 338 Date 11-29-07

Pump Tank: 1500 Gallons: PT 477 Date 12-12-08

Pump Make: Myers Model P102M Serial No. 150

Nitrification Field: No Fields 1 Square Feet 999 Linear Feet 333

No Lines 4@84' Trench Width 2-3' Max Trench Bottom Depth 3' Gravel Depth No

☒ New System ☐ Repair ☐ Expansion System Type: I II III IV V VI

System Description: Pressurized-16" PPBAS

Repair System Description: Same Type

Maintenance Agreement Required: ☒ Yes ☐ No

☒ House/Mod. Home ☐ Mobile Home ☐ Business ☐ Other

No. Bedrooms 5 No. Persons 10 No. Employees

Water Supply: ☐ Individual ☐ Public ☒ Community POINT


☐ Gravity ☒ Pressure ☐ Slab ☐ Crawl Space ☒ Basement w/plumbing ☐ Basement wo/plumbing

Comments/Conditions: Remove old berm and terraces in SFE 13A. Central Valley Boulevard highest elevation.

Comments/Conditions: 8-13-08 CONNECTED KEN INGRAM TO INFORM HIM THAT TANKS MUST BE 15' FROM RETAINING WALL 5' POOL - HE WILL INFORM INSPECTOR (GTM)


3/16" hole drilled checked lines 11/10/09

INITIAL SITE SKETCH (1"=100')

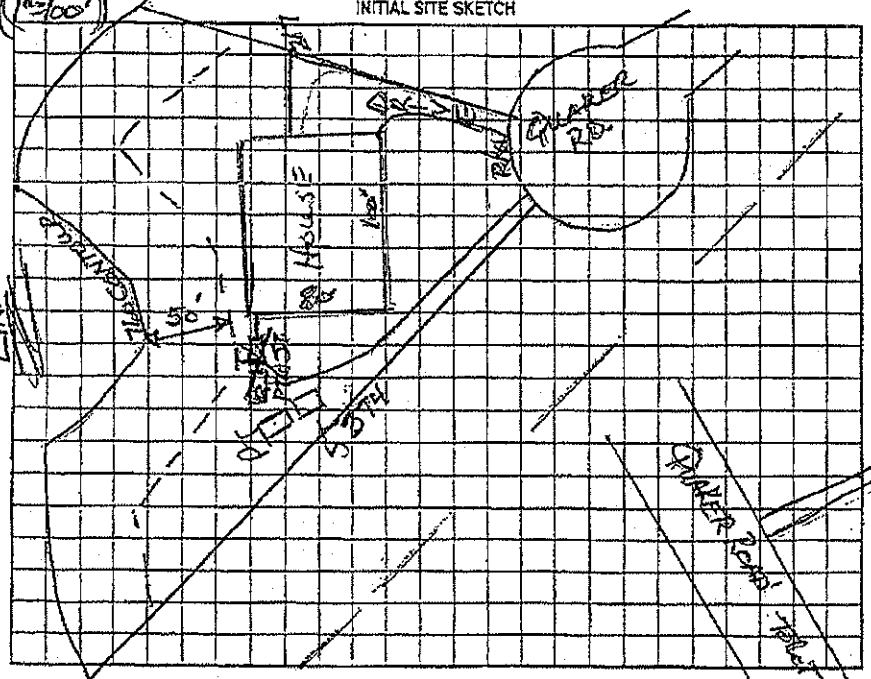

AS BUILT SKETCH

As Built attached. (for Drainfield)
Tanks checked 11/19/10 MET

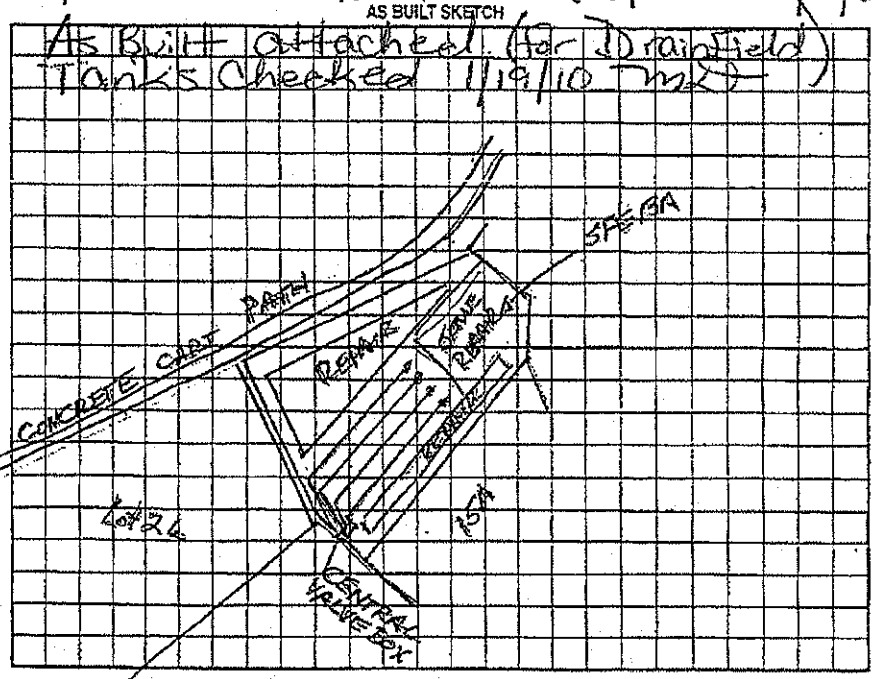

Permit can be suspended or revoked if any false information is supplied toward securing the permit/any unauthorized changes are made to the site/any unauthorized changes are made in the installation of the system. Improvement Permit with plat valid without expiration ☐ Improvement Permit with site plan valid for sixty months ☐ Authorization to Construct is valid for a period equal to that of Improvement Permit – not to exceed sixty months.

Signed: *Michele B. Burton date 8-17-07

Improvement Permit by: Wesley Sparks R.S. date 8/10/07

Authorization to Construct by: [signature] R.S. date 8-11-08

Installed by: R E Hall Const. Co.

Operation Permit by: Marvin Dixon date 3/19/2010

Existing System Inspection by: date

HEALTH DEPT. COPY: WHITE OWNER COPY (FINAL): YELLOW OWNER COPY (INITIAL): PINK