IREDELL COUNTY HEALTH DEPARTMENT

STATESVILLE 704-878-5305 MOORESVILLE 704-664-5281

IMPROVEMENT PERMIT / AUTHORIZATION TO CONSTRUCT / OPERATION PERMIT / EXISTING SYSTEM INSPECTION

125

PERMIT# 075004 PIN# ~~4625446844~~ 4635172879 DATE Nov. 6, '98

OWNER OR CONTRACTOR Crescent Resources Inc. // Augusta Homes PHONE: Business _____ Home _____

ADDRESS P.O. Box 1023 Charlotte

LOCATION Brawley Sch. Rd. TL Quaker Road AT END

SUBDIVISION The Point BLOCK / SECTION 1-C LOT 15/15A LOT AREA 5740 sf + 20,185 sf SITE CLASS PS- 15A DESIGN FLOW 480 gpd L.T.A.R. ~.3 ON 15A

Septic Tank: ~~1000~~ 1500 Gallons; STB 338 Date 4-24-00

Pump Tank: 1000 Gallons; PT 283 Date 9-19-00

Pump Make: _____ Model _____ Serial No. _____

Nitrification Field: No Fields 1 Square Feet 1260 Linear Feet 420

No Lines ~~5 @ 70'~~ Trench Width 36" Max Trench Bottom Depth 36" Gravel Depth NA

☑ New System ☐ Repair System Type: I, II, III, IV, V, VI

System Description: pumped-pm-25% Red/ Innovative on 15A

Repair System Description: LP Pave/ Block on 15A

Maintenance Agreement Required: ☐ Yes ☑ No

☑ House/Mod. Home ☐ Mobile Home ☐ Business ☐ Other

No. Bedrooms 4 No. Bathrooms 4 No. Employees ____


☐ Slab ☐ Crawl Space ☑ Basement w/plumbing ☐ Basement wo/plumbing

Water Supply: ☐ Individual ☑ Public ☑ Community


Comments:/Conditions: * ONE INSPECTION PORT PER LATERAL
11-12-99 Reviewed site & house plan; Appears incompliance
DEH

Comments:/Conditions: Tanks Checked 11/8/2000
Lines checked 11/8/2000
Changed to 5 lines. MD
EZ Lay Drainfield Installed

INITIAL SITE SKETCH

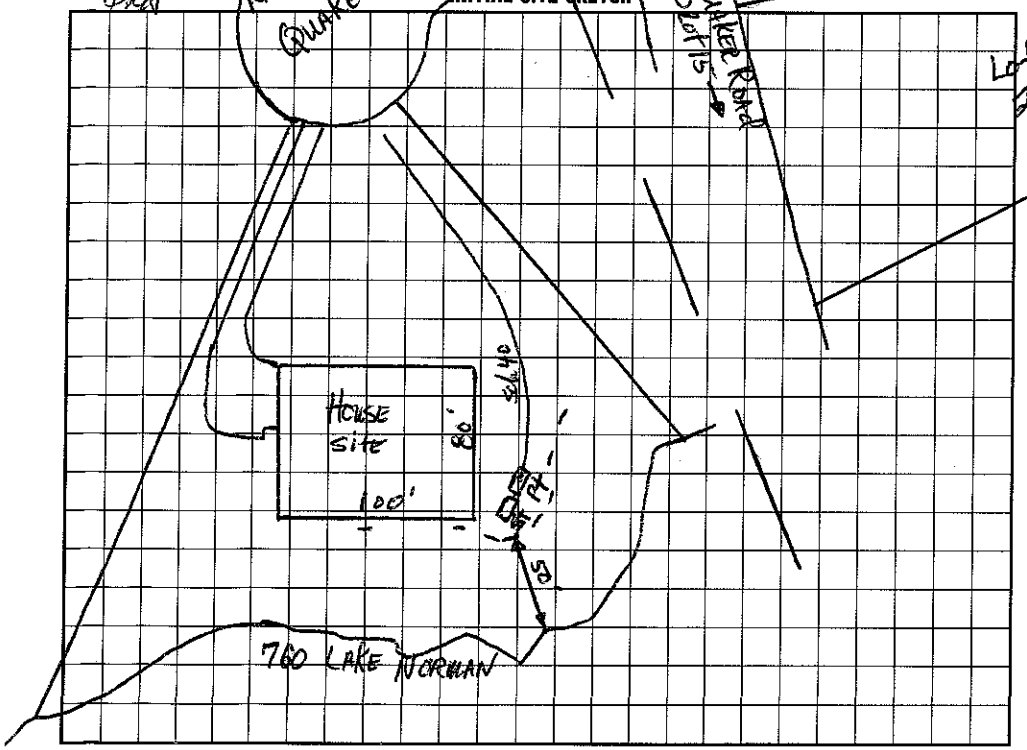

AS BUILT SKETCH

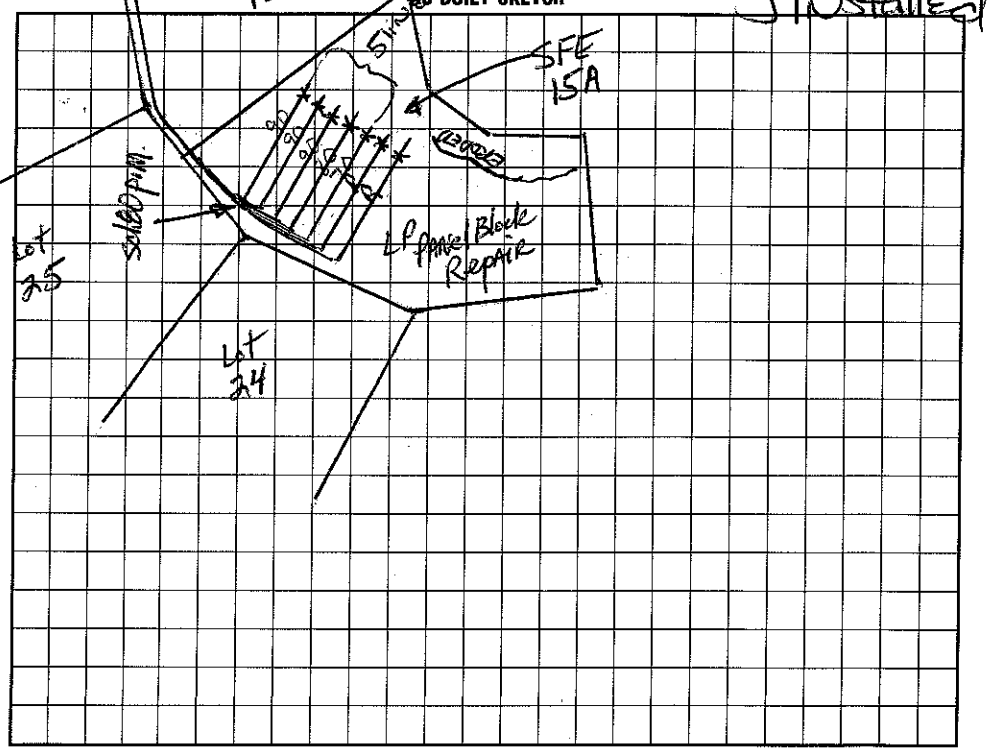

I understand that this permit can be suspended or revoked if any false information is supplied toward securing the permit/any unauthorized changes are made to the site/any unauthorized changes are made in the installation of the system. Improvement Permit with plat valid without expiration. Improvement Permit with site plan valid for sixty months. Authorization to Construct is valid for a period equal to that of Improvement Permit – not to exceed sixty months.

Signed: _____ date 11/10/98

Improvement Permit by: _____ date 11-6-98

Authorization to Construct by: _____ date 11-12-99

Installed by: R & H Inc.

Operation Permit by: _____ date 2/20/2001

Existing System Inspection by: _____ date _____

HEALTH DEPT. COPY: WHITE INSPECTION COPY (FINAL): GREEN OWNER COPY (FINAL): YELLOW INSPECTION COPY (INITIAL): PINK OWNER COPY (INITIAL): GOLD