IREDELL COUNTY HEALTH DEPARTMENT

STATESVILLE 704-878-5305 MOORESVILLE 704-664-5281

As Built

IMPROVEMENT PERMIT / AUTHORIZATION TO CONSTRUCT / OPERATION PERMIT / EXISTING SYSTEM INSPECTION

PERMIT# 122319 PIN# 4625941684 DATE 1-12-05

OWNER OR CONTRACTOR HHZ PHONE: Business Home

ADDRESS 909 East Blvd Charlotte, NC 28203

LOCATION Brawley School Rd & Quaker at end

SUBDIVISION The Point BLOCK / SECTION 1-C LOT 14 LOT AREA SITE CLASS. PS DESIGN FLOW 480 gpd L.T.A.R. .2-.3

Septic Tank: 1500 Gallons; STB 338 Date 11-17-04
Pump Tank: 1000 Gallons; PT 27 Date 11-17-04
Pump Make: Model Serial No.
Nitrification Field: No Fields 1 Square Feet 1050+ Linear Feet 350+
No Lines 6 Trench Width 36" Max Trench Bottom Depth 30" Gravel Depth N/A

☒ New System ☐ Repair System Type: I, II, III, IV, V, VI
System Description: LL Panel Block
Repair System Description: Offsite to 14A - PM to
Maintenance Agreement Required: ☒ Yes ☐ No 25% Reduction


☒ House/Mod. Home ☐ Mobile Home ☐ Business ☐ Other
No. Bedrooms 4 No. Bathrooms 4 No. Employees
☐ Slab ☒ Crawl Space ☐ Basement w/plumbing ☐ Basement wo/plumbing

Water Supply: ☐ Individual ☒ Public ☒ Community


Comments:/Conditions:

Comments:/Conditions:

INITIAL SITE SKETCH Scale 1:50

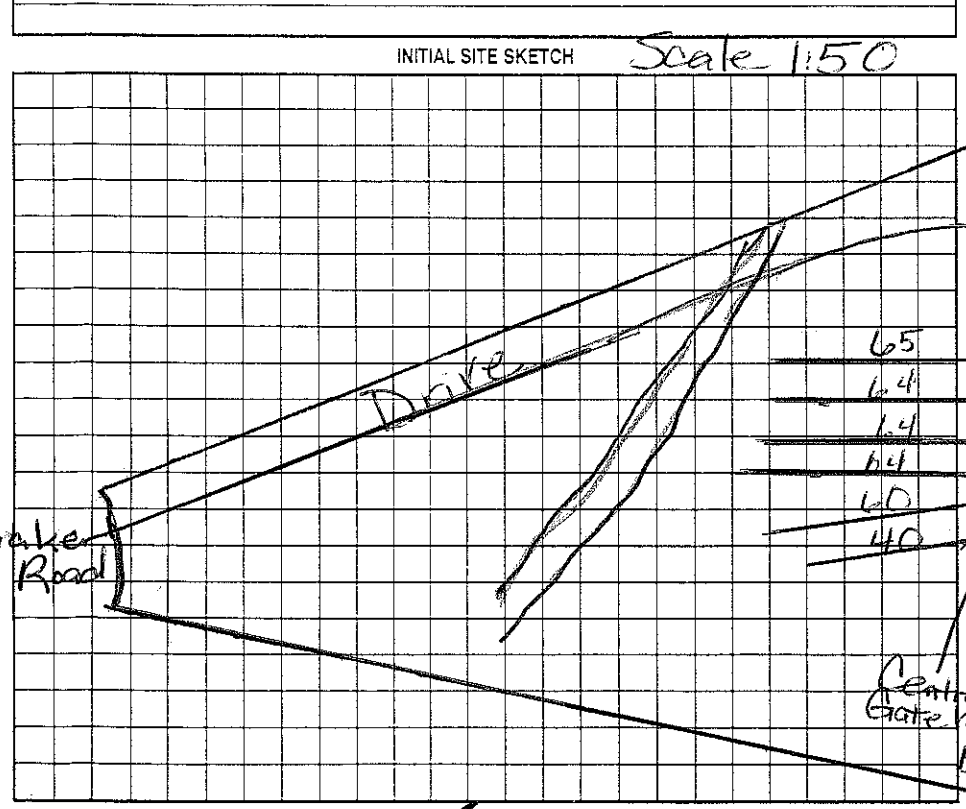

AS-BUILT SKETCH

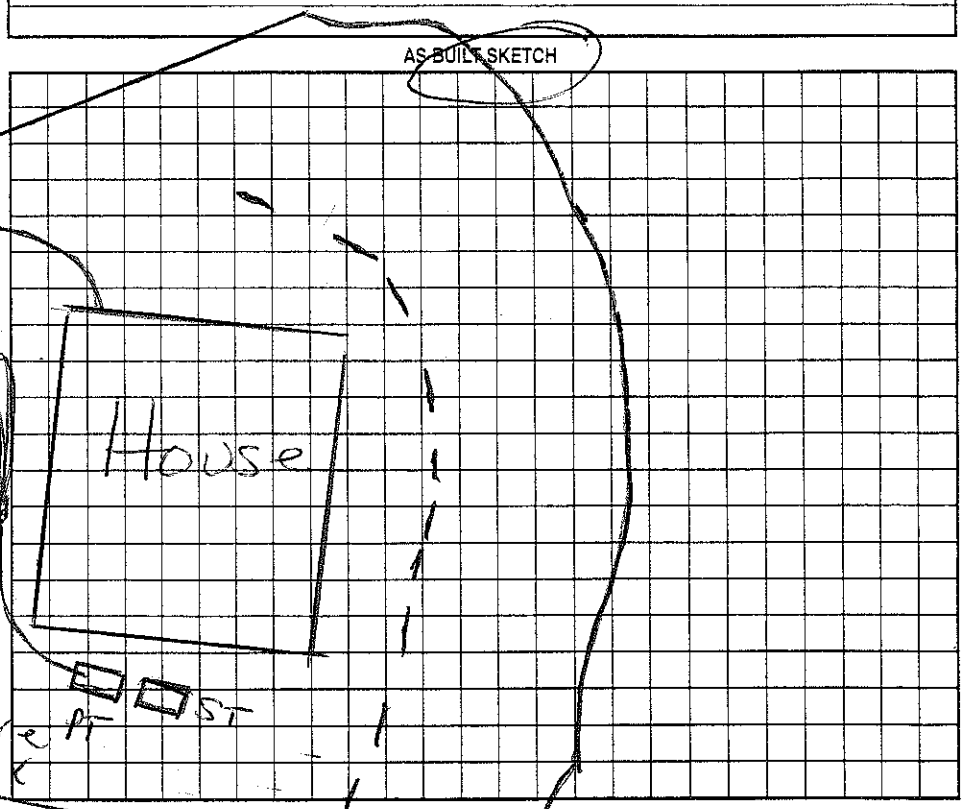

Permit can be suspended or revoked if any false information is supplied toward securing the permit/any unauthorized changes are made to the site/any unauthorized changes are made in the installation of the system. Improvement Permit with plat valid without expiration. Improvement Permit with site plan valid for sixty months. Authorization to Construct is valid for a period equal to that of Improvement Permit – not to exceed sixty months.

Signed: date 1-11-05 Installed by: Bobby Mayhew RS

Improvement Permit by: date

Authorization to Construct by: Maria HHZ Dotson date 1/12/05 Operation Permit by: Maria HHZ Dotson date 1/12/05

Existing System Inspection by: date

HEALTH DEPT. COPY: WHITE OWNER COPY (FINAL): YELLOW OWNER COPY (INITIAL): PINK