IREDELL COUNTY HEALTH DEPARTMENT

STATESVILLE 704-878-5305 MOORESVILLE 704-664-5281

IMPROVEMENT PERMIT / AUTHORIZATION TO CONSTRUCT / OPERATION PERMIT / EXISTING SYSTEM INSPECTION

2:00 pm

PERMIT# 07502 PIN# 4625941684 4635 18 0120 DATE Oct 26, '98

OWNER OR CONTRACTOR Crescent Resources Inc. / DAVID DIBBLE PHONE: Business _____ Home _____

ADDRESS P.O. Box 1003, Charlotte

LOCATION Brawley Sch. Rd. TL Quaker Rd. on left at jct w/ Hadley Harbor Ct 195 Quaker Rd

SUBDIVISION The Point BLOCK / SECTION 1-C LOT 17 LOT AREA 44428ft² SITE CLASS. RS DESIGN FLOW 480gpd L.T.A.R. .25-.3

Septic Tank: ~~1000~~ 1500 Gallons; STB 338 Date 2-02-02 ☑ New System ☐ Repair System Type: I, II, (III) IV, V, VI

Pump Tank: 1000 Gallons; PT 27 Date 4/7/02 System Description: pumped pm - 25% Reduction

Pump Make: Goulds Model 1WE05021HH Serial No. G015835 Repair System Description: LPP 25-50% Reduction

Nitrification Field: No Fields 1 Square Feet 1425 Linear Feet 475 Maintenance Agreement Required: ☐ Yes ☑ No

No Lines 5@95' Trench Width 36" Max Trench Bottom Depth 36" Gravel Depth NA

☑ House/Mod. Home ☐ Mobile Home ☐ Business ☐ Other

No. Bedrooms 4 No. Bathrooms 4 No. Employees ____


☑ Slab ☑ Crawl Space ☑ Basement w/plumbing ☐ Basement wo/plumbing

Water Supply: ☐ Individual ~~☐ Public~~ ☑ Community


Comments:/Conditions: ONE inspection port per LATERAL. Remove any old burms, terraces.

Comments:/Conditions: (partial) EZ Flow lines installed. Filter(s) installed Tanks & pressure checked 5/9/2002

INITIAL SITE SKETCH 1"=50'

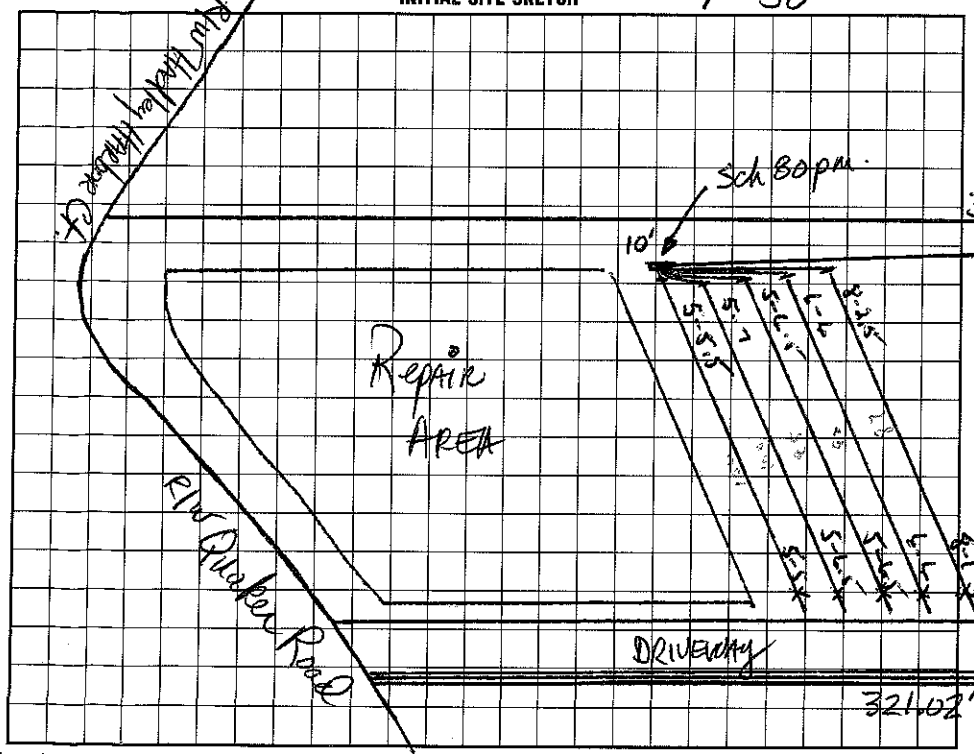

AS BUILT SKETCH

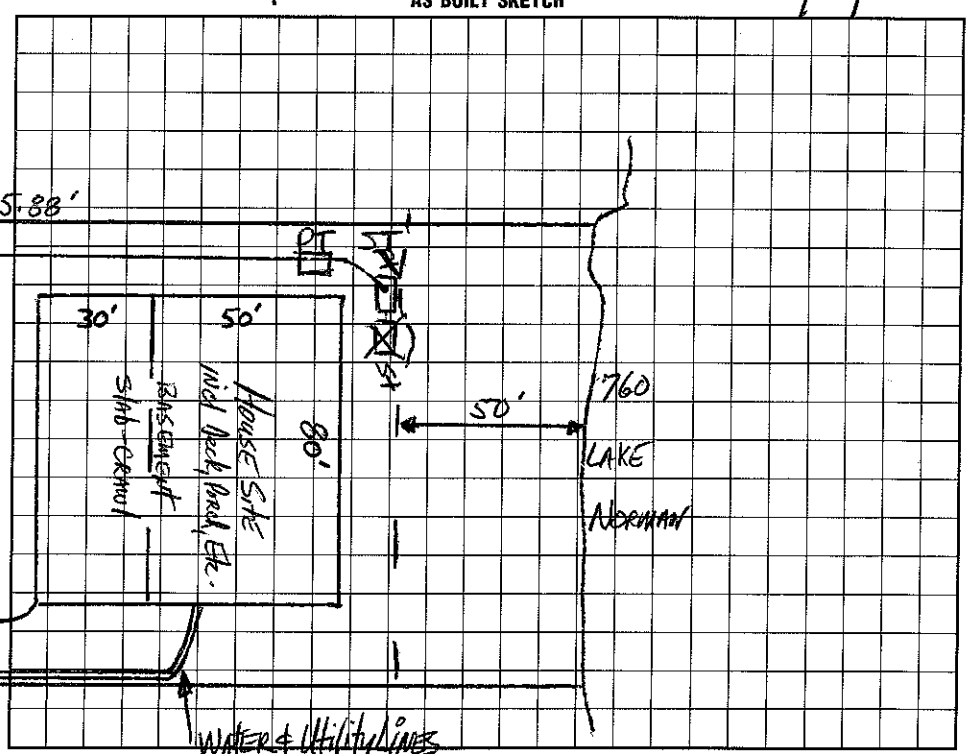

I understand that this permit can be suspended or revoked if any false information is supplied toward securing the permit/any unauthorized changes are made to the site/any unauthorized changes are made in the installation of the system. Improvement Permit with plat valid without expiration. Improvement Permit with site plan valid for sixty months. Authorization to Construct is valid for a period equal to that of Improvement Permit – not to exceed sixty months.

Signed: _____ date 10-30-98 Installed by: Orbison & Sons RS

Improvement Permit by: _____ RS date 10-21-98 Operation Permit by: _____ date 8/16/02

Authorization to Construct by: _____ RS date 12/5/01 Existing System Inspection by _____ date _____

HEALTH DEPT. COPY: WHITE INSPECTION COPY (FINAL): GREEN OWNER COPY (FINAL): YELLOW INSPECTION COPY (INITIAL): PINK OWNER COPY (INITIAL): GOLD