IREDELL COUNTY HEALTH DEPARTMENT

STATESVILLE 704-878-5305 $280 MOORESVILLE 704-664-5281

IMPROVEMENT PERMIT / AUTHORIZATION TO CONSTRUCT / OPERATION PERMIT / EXISTING SYSTEM INSPECTION

PERMIT# 115578 PIN# ~~4636 20 0115~~ ~~4636.~~ 4635-19-1833 DATE 10/16/03

OWNER OR CONTRACTOR Wm. Flannery PHONE: Business _____ Home 704-663-7162

ADDRESS 139 Cove Creek Rd. Mooresville, NC 28115

LOCATION 1100 TL 4th left Pines TR Cove Creek to 139 on (L) B4 lake crossing

SUBDIVISION North Shore BLOCK/SECTION 1 LOT 14 LOT AREA .8 Ac SITE CLASS. PS DESIGN FLOW 600 L.T.A.R. .3

Septic Tank: EXISTING Gallons; STB _____ Date _____

Pump Tank: _____ Gallons; PT _____ Date _____

Pump Make: _____ Model _____ Serial No. _____

Nitrification Field: No Fields 2 Square Feet 480 Linear Feet 160

No Lines 2@80 Trench Width 3 Max Trench Bottom Depth 3 Gravel Depth N/A

☐ New System ☐ Repair System Type: I, II, (III) IV, V, VI

System Description: Addition – 25% Reduced Drainfield

Repair System Description: Pressure to front yard

Maintenance Agreement Required: ☐ Yes ☒ No

☒ House/Mod. Home ☐ Mobile Home ☐ Business ☐ Other

No. Bedrooms 5 No. Bathrooms 4 No. Employees ____

☐ Slab ☒ Crawl Space ☐ Basement w/plumbing ☐ Basement wo/plumbing


Water Supply: ☐ Individual ☐ Public ☒ Community

Comments/Conditions: FD = FLOW DIVIDER O = ORIGINAL N = NEW
Add Flow Divider and 2 25% reduced drain lines to lower Dist. Box


Comments/Conditions: E-Z FLOW INSTALLED.

(1" = 30')

INITIAL SITE SKETCH

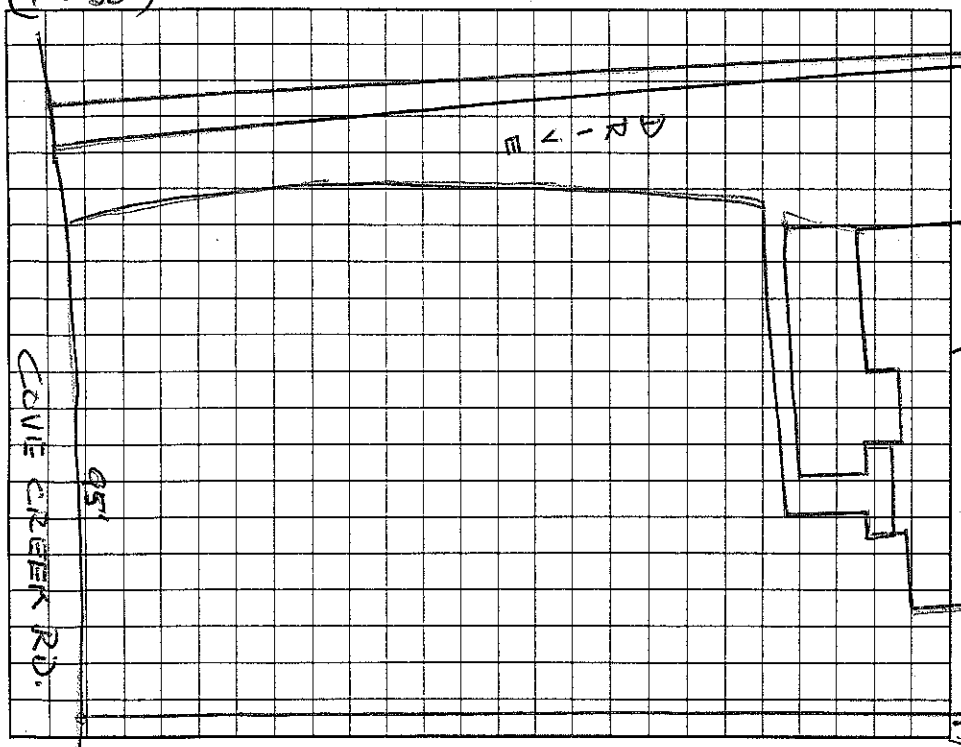

AS BUILT SKETCH

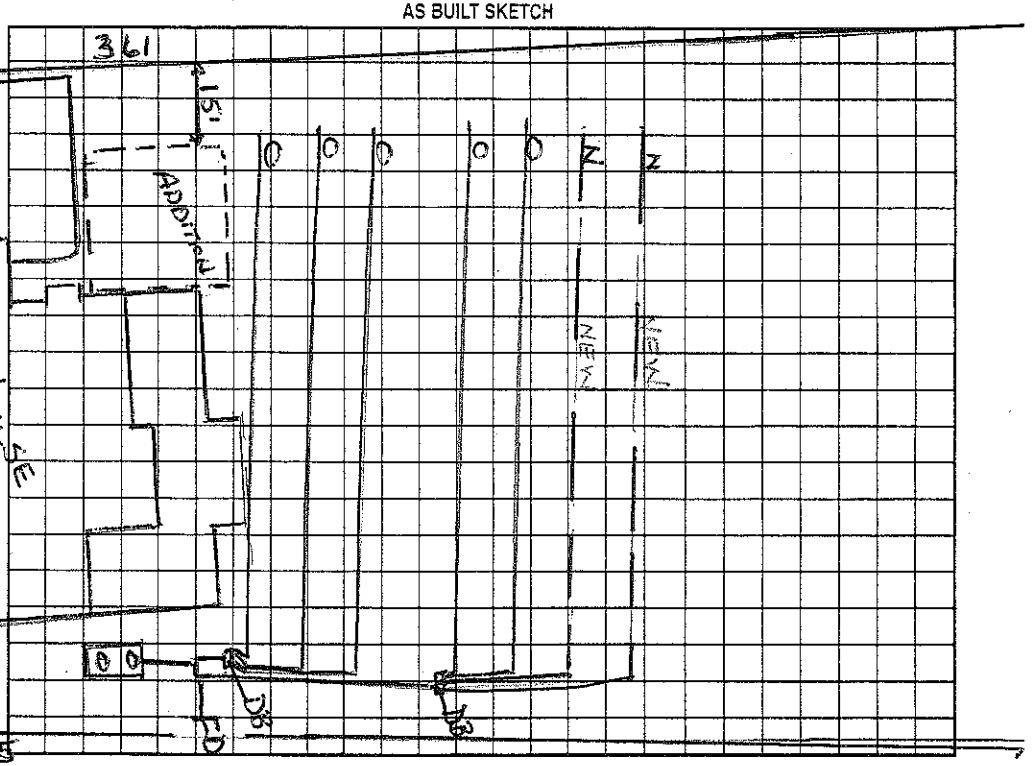

Permit can be suspended or revoked if any false information is supplied toward securing the permit/any unauthorized changes are made to the site/any unauthorized changes are made in the installation of the system. Improvement Permit with plat valid without expiration. Improvement Permit with site plan valid for sixty months. Authorization to Construct is valid for a period equal to that of Improvement Permit – not to exceed sixty months.

Signed: * _____ date _____

Improvement Permit by: Wesley Sparks RS. date 10/16/03

Authorization to Construct by: Wesley Sparks RS. date 10/16/03

Installed by: Cantry Concrete Works

Operation Permit by: Wesley Sparks RS. date 11/25/03

Existing System Inspection by: _____ date _____

HEALTH DEPT. COPY: WHITE OWNER COPY (FINAL): YELLOW OWNER COPY (INITIAL): PINK