IREDELL COUNTY HEALTH DEPARTMENT

STATESVILLE 704-878-5305 MOORESVILLE 704-664-5281

IMPROVEMENT PERMIT / CERTIFICATE OF COMPLETION / OPERATION PERMIT / EXISTING SYSTEM INSPECTION

PROPERTY DESCRIPTION NO. 46630 DATE Oct. 21, '93 TAX MAP NO. 2G 23.B 14 Watershed: ☑ Yes ☐ No

OWNER OR CONTRACTOR Robert Clingenhem Homes PHONE: Business (704) 391-3715 ~~Home~~ 4636-19-1833 LAKE NORMAN

ADDRESS 2900 B IES S. Service Rd. Charlotte

LOCATION 1100 TL 1113 TR Cove Creek Rd. TL Wynswept TL Wynward at end on left

SUBDIVISION North Shore BLOCK / SECTION 2 LOT 14 LOT AREA ± 20,000 ft² SITE CLASS PS per 1950 DESIGN FLOW 480 gpd L.T.A.R. .25

Septic Tank: 1000 Gallons; STB 744 Pellinger Date 8/18/93

Pump Tank: ____ Gallons; PT ____ Date ____

Pump Make: ____ Model ____ Serial No. ____

Nitrification Field: No Fields 2 Square Feet ____ Linear Feet 320

No Lines 6 Trench Width 24" Max Trench Bottom Depth ~36" Gravel Depth NA

☑ New System ☐ Repair System Type: I, II, (III), IV, V, VI

System Description: gravity PPBPS

Repair System Description: SAME or LP PPBPS

Maintenance Agreement Required: ☐ Yes ☑ No NOT ON initial system

☑ House/Mod. Home No. Bedrooms 4

☐ Mobile Home No. Bathrooms 2½

☐ Business No. Employees ____

☐ Other ____

☐ Slab ☑ Crawl Space ☐ Basement w/plumbing ☐ Basement wo/plumbing


Water Supply: ☐ Individual ☑ Community ☐ Public

Comments:

Comments:

INITIAL SITE SKETCH

AS BUILT SKETCH

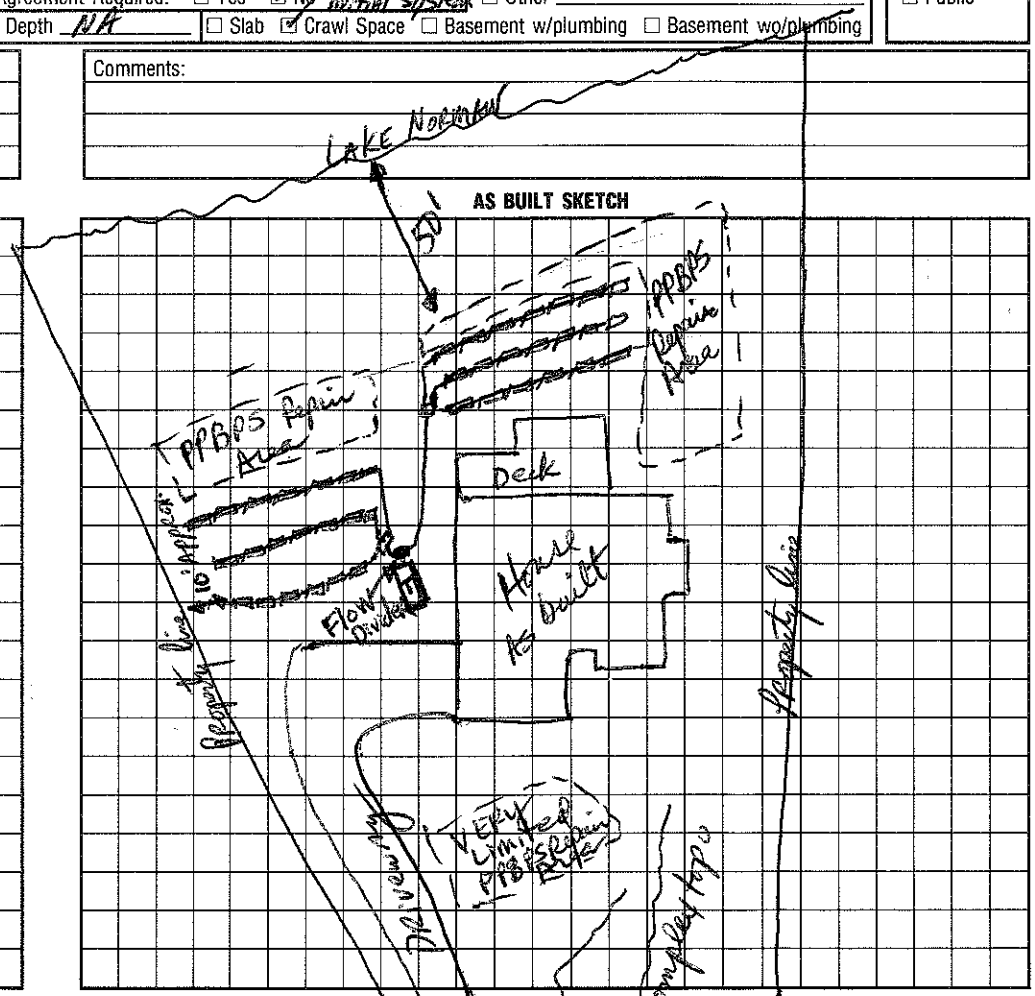

I understand that this permit can be suspended or revoked if any false information is supplied toward securing the permit/any unauthorized changes are made to the site/any unauthorized changes are made in the installation of the system. Improvement Permit is valid for 60 months from date of issuance.

Signed: ____

Improvement Permit by: ____ date ____

Existing System Inspection by: ____ date ____

Installed by: Ironhorse Grading

Certificate of Completion by: ____ date ____

Operation Permit by: [illegible] date ____

HEALTH DEPT. COPY: WHITE INSPECTION COPY (FINAL): GREEN OWNER COPY (FINAL): YELLOW INSPECTION COPY (INITIAL): PINK OWNER COPY (INITIAL): GOLD