[ ]ELL COUNTY HEALTH DEPARTMENT

STATESVILLE 704-878-5305 MOORESVILLE 704-664-5281

IMPROVEMENT PERMIT / CERTIFICATE OF COMPLETION / OPERATION PERMIT / EXISTING SYSTEM INSPECTION

PROPERTY DESCRIPTION NO. 18420 DATE May 6, 1994 TAX MAP NO. 2613 B13 4635 19 1993 Watershed: ☑ Yes ☐ No

OWNER OR CONTRACTOR Robert Langhorne Homes PHONE: Business 391-3715 Home

ADDRESS 2900-B I-85 Service Rd, Charlotte, NC 28208

LOCATION 1100 TL 1113

SUBDIVISION North Shore BLOCK / SECTION II, pH L LOT 13 LOT AREA ~107'x262' SITE CLASS. PS per 11956 DESIGN FLOW 480 gpd L.T.A.R. .3

Septic Tank: 1000 Gallons; STB 794 Date 1-25-94

Pump Tank: 1000 Gallons; PT Date

Pump Make: Model Serial No.

Nitrification Field: No. Fields 2 Square Feet 1620 Linear Feet 540 ~~270~~ 378

No Lines 4+4 Trench Width 36" Max Trench Bottom Depth 36" Gravel Depth 12"

☑ New System ☐ Repair System Type: I, II, III, IV, V, VI

System Description: pumped conventional

Repair System Description: LPPPBPS

Maintenance Agreement Required: ☐ Yes ☑ No

☑ House/Mod. Home No. Bedrooms 4

☐ Mobile Home No. Bathrooms 3.5

☐ Business No. Employees

☐ Other

☐ Slab ☑ Crawl Space ☐ Basement w/plumbing ☐ Basement wo/plumbing

Water Supply: ☐ Individual ☑ Community ☐ Public


Comments: * Maintenance agreement will be required for future CPPBPS repair.

Gravity Panel OK to use for initial system 8/25/94


Comments:

760 LN

INITIAL SITE SKETCH

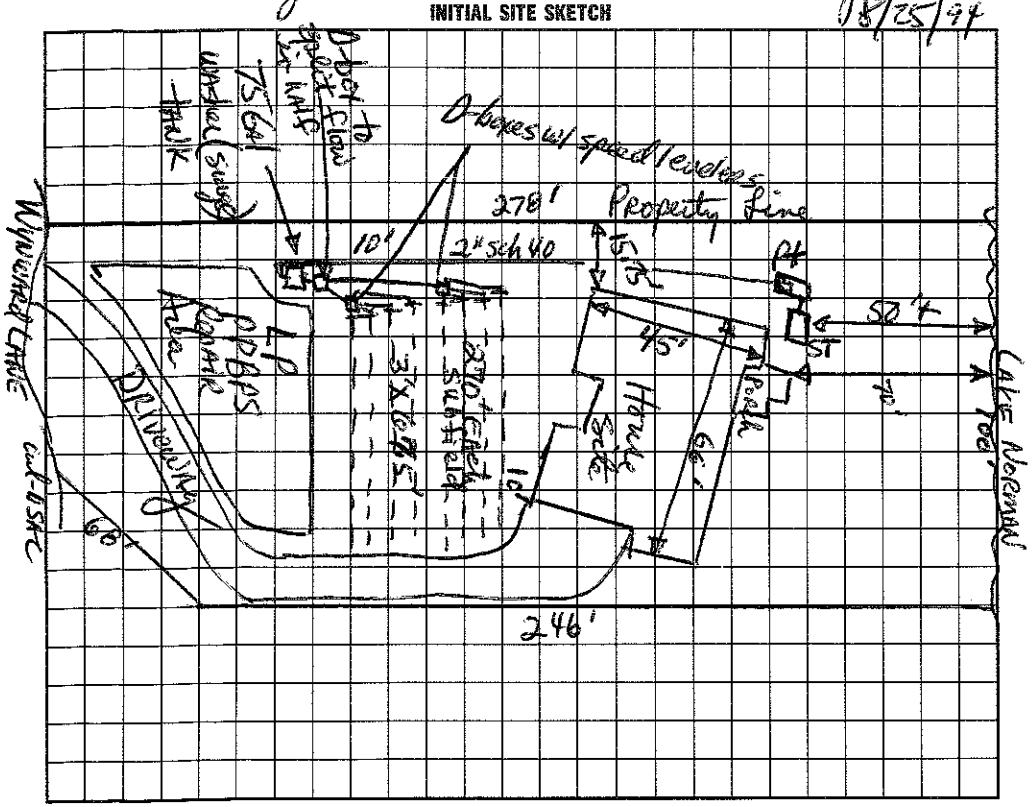

AS BUILT SKETCH

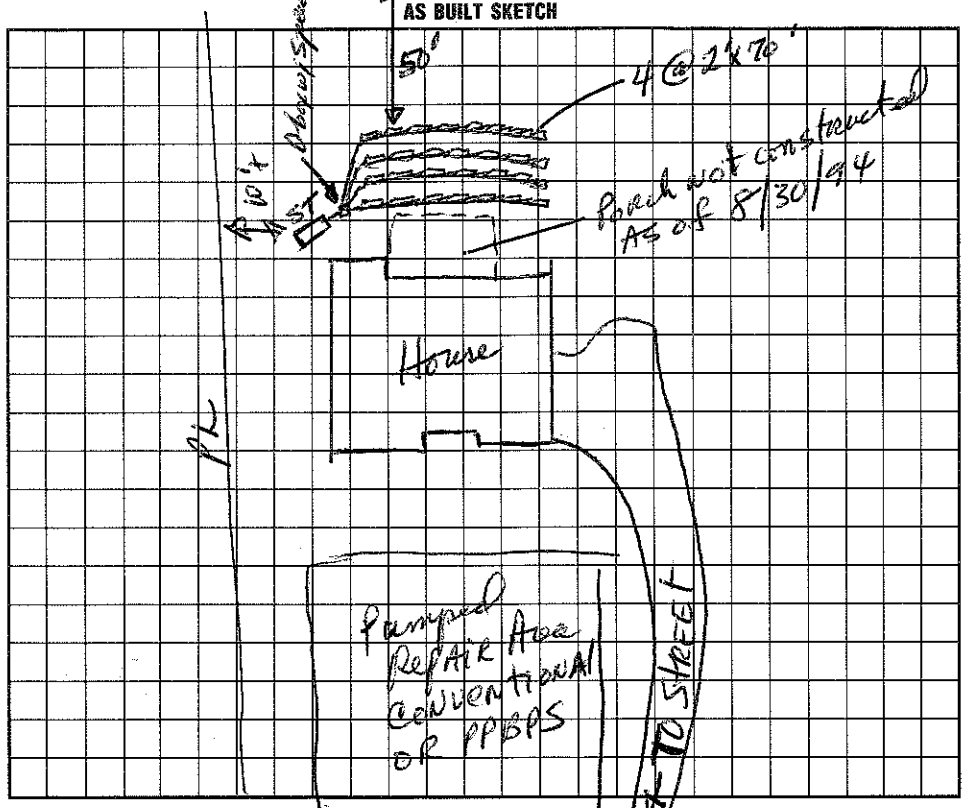

I understand that this permit can be suspended or revoked if any false information is supplied toward securing the permit/any unauthorized changes are made to the site/any unauthorized changes are made in the installation of the system. Improvement Permit is valid for 60 months from date of issuance.

Signed: X

Improvement Permit by: James R Hamrick, RS date 5/6/94

Existing System Inspection by: date

Installed by: Thorhorse Grading / KEN PAINTER

Certificate of Completion by: date

Operation Permit by: James R Hamrick, RS date 8/30/94

HEALTH DEPT. COPY: WHITE INSPECTION COPY (FINAL): GREEN OWNER COPY (FINAL): YELLOW INSPECTION COPY (INITIAL): PINK OWNER COPY (INITIAL): GOLD