IREDELL COUNTY HEALTH DEPARTMENT

Statesville Office (704) 878-5305 — Mooresville Office (704) 660-3625

PERMIT # 242429

SEPTIC IMPROVEMENT PERMIT / AUTHORIZATION TO CONSTRUCT / OPERATION PERMIT / EXISTING SYSTEM

PIN # 4635196169

APPLICANT/OWNER: Darron Deal — APPLICANT ADDRESS: 171 Waterford Drive Mooresville

SITE ADDRESS: 171 Waterford Dr Mooresville — PHONE: 704-516-0659 — ALT. PHONE

SITE DIRECTIONS: Brawley School Road L on Isle of Pines R on Waterford 171 in cul de sac — SAP CONTROLLED: ☐ YES ☐ NO

SUBDIVISION: Pine Isle — SECTION: P1 — LOT # 35 — LOT AREA: 1.11 — DESIGN FLOW: 480 gpd — L.T.A.R.: Existing

Septic Tank 1500 (gal) — STB 964 — Date 3-26-19

Pump Tank 1500 (gal) — PT 353 — Date 3-21-19

Pump Make Goulds — Model 3HP — Serial # WE0311M

Nitrification Fields 1 — # Lines 1 — Linear Ft 90

Trench Width — Trench Bottom Depth (Low side) — Gravel Depth —

☐ New System ☒ Repair ☐ Expansion — System Type: I II III IV V VI

System Description: LP PPBS Existing

Repair System Description: Tank

Maintenance Agreement Required: ☒ YES ☐ NO

☐ GRAVITY ☒ PRESSURE

☒ Residence — No. Bedrooms 4

☐ Business — No. Persons 8

☐ Other — No. Employees


☐ Slab — ☒ Crawl Space

☐ Basement w/plumbing — ☐ Basement w/o plumbing

Water Supply: ☐ Private ☐ Public ☒ Community

Comments / Conditions: Pump, Crush, and haul old tank away. New tank must be installed in same place as old tank. Pump tank must have inline filter.

INITIAL SITE SKETCH

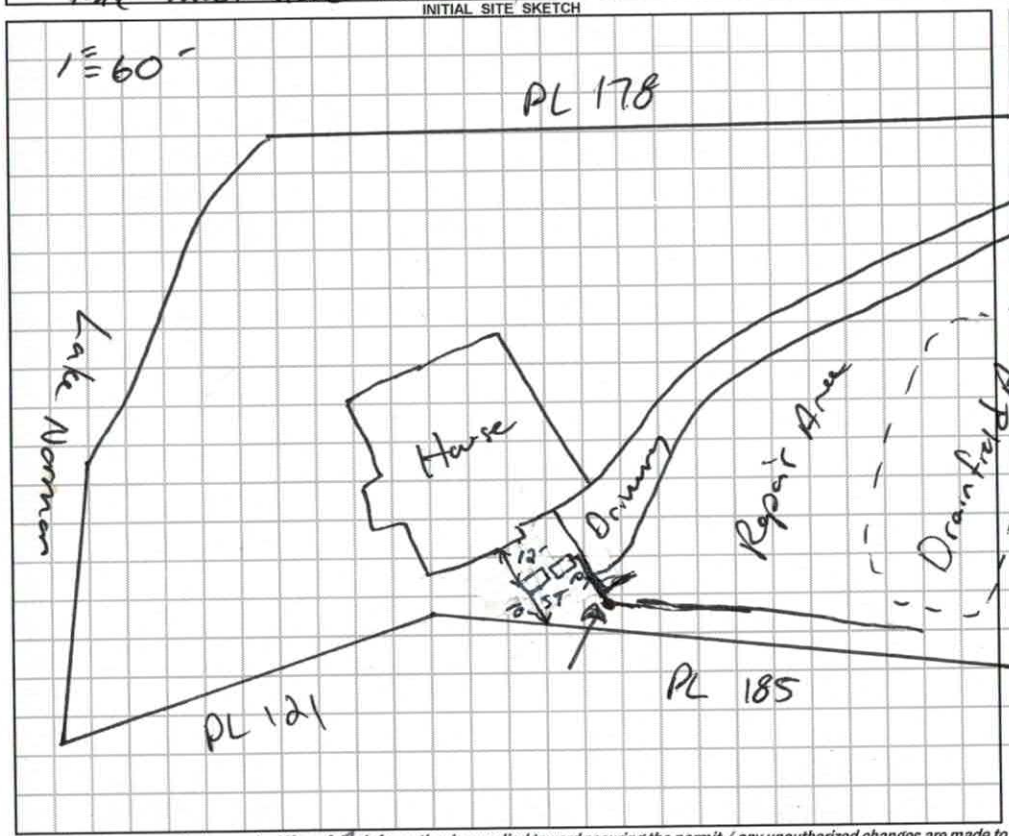

AS BUILT SKETCH

-new pump tank installed
-supply line rerouted around drive

Installed as shown

Permit can be suspended or revoked if any false information is supplied toward securing the permit / any unauthorized changes are made to the site / any unauthorized changes are made in the installation of the system. **CONTACT A LOCATOR SERVICE PRIOR TO ANY EXCAVATION**

☐ **IMPROVEMENT PERMIT** *with plat valid without expiration.* ☑ **IMPROVEMENT PERMIT** *with site plan valid for 60 mos.* ☑ **AUTHORIZATION TO CONSTRUCT** *valid for period equal to IMPROVEMENT PERMIT--not to exceed 60 mo.*

Owner / Applicant Signature: — Date: 6/4/19 — Installed by: Lentz Wastewater

IMPROVEMENT PERMIT by: — Date: 2-28-19 — OPERATION PERMIT by: Kayla Wilson — Date: 6-21-19

AUTHORIZATION TO CONSTRUCT by: — Date: 2-28-19 — Existing System Inspected by: — Date:

FOR SEPTIC FINAL INSPECTION: CALL 704-664-3703 between 8am-9am the day the inspection is needed. Be sure to speak with an inpsector to confirm your inspection time.

#242429
Rep. Eval. no charge.

IREDELL COUNTY DEPARTMENT of ENVIRONMENTAL HEALTH

APPLICATION FORM

Application For: ( ) New Well Permit ( ) Well Repair Permit ( ) Well Abandonment
( ) Septic Improvement Permit ( ) Authorization to Construct ( ) Existing System Inspection (✓) Septic System Repair

THE ABOVE PERMIT DOCUMENTS WILL BECOME INVALID IF INFORMATION PROVIDED ON THIS APPLICATION IS FALSIFIED OR CHANGED, OR IF THE SITE IS ALTERED. THE IMPROVEMENT PERMIT IS VALID FOR EITHER 60 MONTHS OR WITHOUT EXPIRATION DEPENDING UPON DOCUMENTATION SUBMITTED. APPLICATION WITH SITE PLAN 60 MONTHS, APPLICATION WITH COMPLETE, SCALED PLAT WITHOUT EXPIRATION. SEE 15A NCAC 18A .1937(f) FOR DETAILS.

Page 2: *Site Plan Worksheet* form MUST accompany this application

The following optional attachments may also be submitted: ( ) Survey Plat, scaled no more than 1 inch = 60 feet
Place an (X) beside whichever is submitted if applicable ( ) Custom Site Plan, scaled no more than 1 inch = 60 feet

Applicant Information: (PRINT CLEARLY)

Applicant Name: Darron DEAL Address: 171 Waterford Dr Zip: 28117
Applicant Email: RAZZFUNDS@yahoo.com Phone: 704-516-0659 Alt. Phone: ____
Owner Name: Darron Deal Address: 171 Waterford Drive Mooresville N.C. Zip: 28117
Owner Email: razzfunds@yahoo.com Phone: — Alt. Phone: —

Property Information:

Street Address: 171 Waterford Drive
Subdivision Name: Pine Isle Section/Phase: ____ Lot Number: ____
Driving Directions: ____

Site Development Information: *(check or complete ALL that apply*

( ) New Single Family Residence
( ) New Multi-Family Residence
( ) Accessory Building
( ) Bedroom(s) Addition
(✓) Repair to failing septic system ✓ Tank ___ Drain lines Describe Problem: Failing tank concrete
Maximum Number of Bedrooms: 4
Maximum Number of Occupants: ____
( ) Swimming Pool
( ) Other Addition/Structure: ____
Non-Residential Site Development: Type of Business: ____
Square Footage of Building: ____ Max. Number of Employees: ____ Max. Number of Seats/Beds/Other: ____

CHECK FOUNDATION TYPE

(✓) Crawl Space Foundation
( ) Concrete Slab Foundation
( ) Basement with Plumbing
( ) Basement without Plumbing

Water Supply: ( ) Replacement Well – Reason: ____
( ) Multi-connection Well Number of Houses: ____ Number of Persons: ____
( ) New Well ( ) Existing Well ( ) Community Well ( ) City Water ( ) Other Public Water

Desired Septic System Type: *(you may rank in order of preference)* Year existing system installed: 92
(✓) No Preference ( ) Alternative ( ) Conventional ( ) Innovative ( ) Modified Conventional ( ) Other: ____

Please answer the following to the best of your ability:
( ) Yes (✓) No Does the site contain any jurisdictional wetlands?
( ) Yes (✓) No Is any non-domestic sewage (i.e. industrial) to be generated?
( ) Yes (✓) No Is the site subject to approval by any other public agency?

I have read this application and certify that the information provided herein is true, complete, and correct. Authorized county and state officials are granted right of entry to conduct necessary inspections to determine compliance with applicable laws and rules. I understand that I am solely responsible for the proper identification and labeling of all property lines and corners and making the site accessible so that a complete site evaluation can be performed.

Signature: ____ 1/13/19
Property owner or owner's legal representative signature (SIGNATURE REQUIRED) DATE

IREDELL COUNTY DEPARTMENT OF ENVIRONMENTAL HEALTH

DOCUMENTATION TO AUTHORIZE AN OWNER'S LEGAL REPRESENTATIVE

(Check and sign only ONE of the options below)

1. *** APPLICANT AND OWNER ARE THE SAME. *** (*Sign here*) _____

Applications for permits require the "signature of the owner or owner's legal representative" (15A NCAC 18A .1937). If the owner does not sign the application himself or herself, they can submit any one of the following documents to designate their legal representative: *Power of Attorney; Real Estate Contract; Estate executor; Bankruptcy trustee; Court ordered guardianship*
In the absence of the above documentation, the property owner may provide the local health department with documentation that designates a legal representative. A property owner may:
Complete this form to document his or her legal representative, or provide his or her own form that contains the information in this form. If there are multiple property owners, then all property owners must sign the form that designates a legal representative.
By signing a form that designates a legal representative for purposes of 15A NCAC 18A .1937, the property owner authorizes that representative to act on their behalf in matters pertaining to the application and permitting process, including signing or receiving any application, document or permit. The owner retains full responsibility to meet all permit conditions specified by the local health department.

2. I, Darron Deal, am the legal owner(s) of the property located at 171 Waterford Dr, identified as

PIN (Parcel Identification Number) 4635196169, located in Iredell County, North Carolina.

I do hereby authorize (**print legal representative/company name**) Lentz Waste, _____, to act as an agent on my behalf in applying for/signing/obtaining any of the documents described below.

- Application for Improvement Permit (IP) / Authorization to Construct (AC)
- Improvement Permit (IP) / Authorization to Construct (AC)
- Application for soil-site evaluation (new/repair)
- Application/permit for private drinking water well/well abandonment
- Application for Compliance Inspection

I agree to abide by all decisions and/or conditions between the legal representative acting on my behalf and the Iredell County Department of Public Health, Environmental Health Division.

_____ 1/23/19
Signature of Owner(s) Date

Mooresville - Environmental Health
ronda.hart@co.iredell.nc.us
Fax: 704-662-3239
610 E. Center Avenue, Mooresville, NC 28115

Statesville - Environmental Health
adrienne.shea@co.iredell.nc.us
Fax: 704-871-3483
349 N. Center Street, Statesville, NC 28677