IREDELL COUNTY HEALTH DEPARTMENT

STATESVILLE 704-878-5305 MOORESVILLE 704-664-5281

IMPROVEMENT PERMIT / CERTIFICATE OF COMPLETION / OPERATION PERMIT / EXISTING SYSTEM INSPECTION

PROPERTY DESCRIPTION NO. 8235 DATE May 31, '94 TAX MAP NO. 2623A30 4635197717 Watershed: ☑ Yes ☐ No

OWNER OR CONTRACTOR Don McKay PHONE: Business _____ Home _____

ADDRESS 116 Waterford Drive Mooresville L.N.

LOCATION SR 1113 To Waterford Drive on Rt just past amenity (pool) area

SUBDIVISION Pine Isle BLOCK / SECTION _____ LOT 30 LOT AREA 117'x226' SITE CLASS. ☑ pre.1950 DESIGN FLOW 480 gpd L.T.A.R. .3

Septic Tank: Existing Gallons; STB _____ Date _____

Pump Tank: Existing Gallons; PT _____ Date _____

Pump Make: _____ Model _____ Serial No. _____

Nitrification Field: No Fields 1 Square Feet _____ Linear Feet 140+Ex.

No Lines 2+Ex Trench Width 24" Max Trench Bottom Depth 36" Gravel Depth N/A

☐ New System ☑ Repair System Type: I, II, III, IV, V, VI

System Description: LPPPRS

Repair System Description: Same

Maintenance Agreement Required: ☑ Yes ☐ No

☑ House/Mod. Home No. Bedrooms 4 2½

☐ Mobile Home No. Bathrooms

☐ Business No. Employees

☐ Other


☐ Slab ☐ Crawl Space ☐ Basement w/plumbing ☐ Basement wo/plumbing

Water Supply: ☐ Individual ☑ Community ☐ Public


Comments: 2 Existing laterals to be replaced due to garage and driveway addition. Use one 3/16" hole per panel. Maintenance agreement now required.

Comments:

INITIAL SITE SKETCH

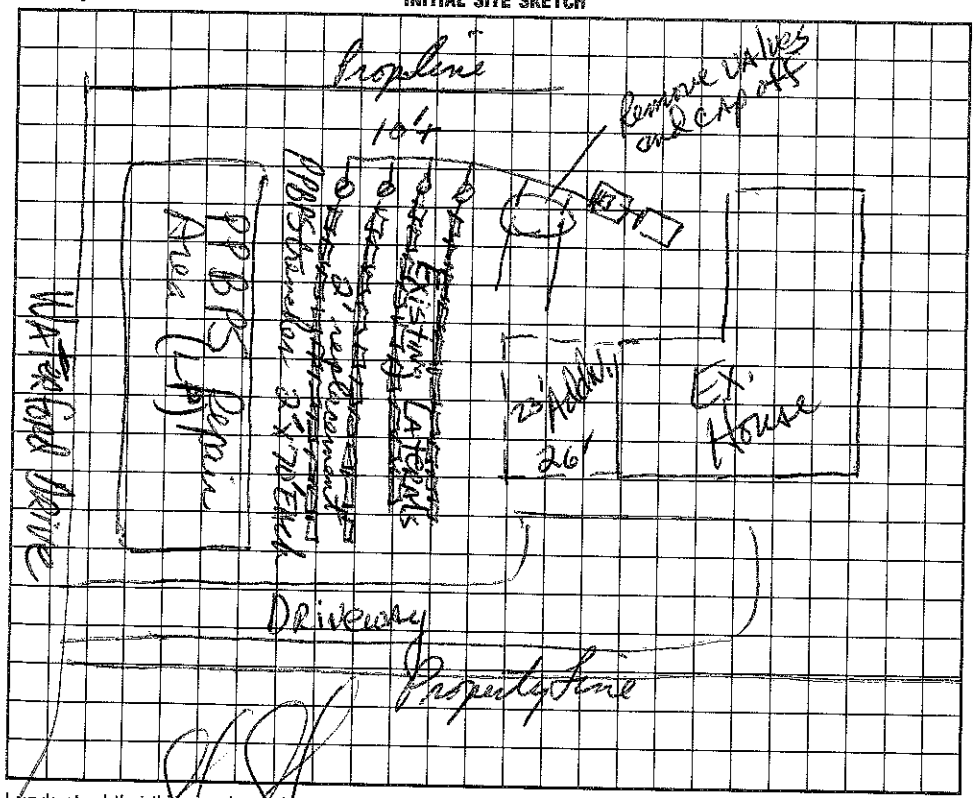

AS BUILT SKETCH

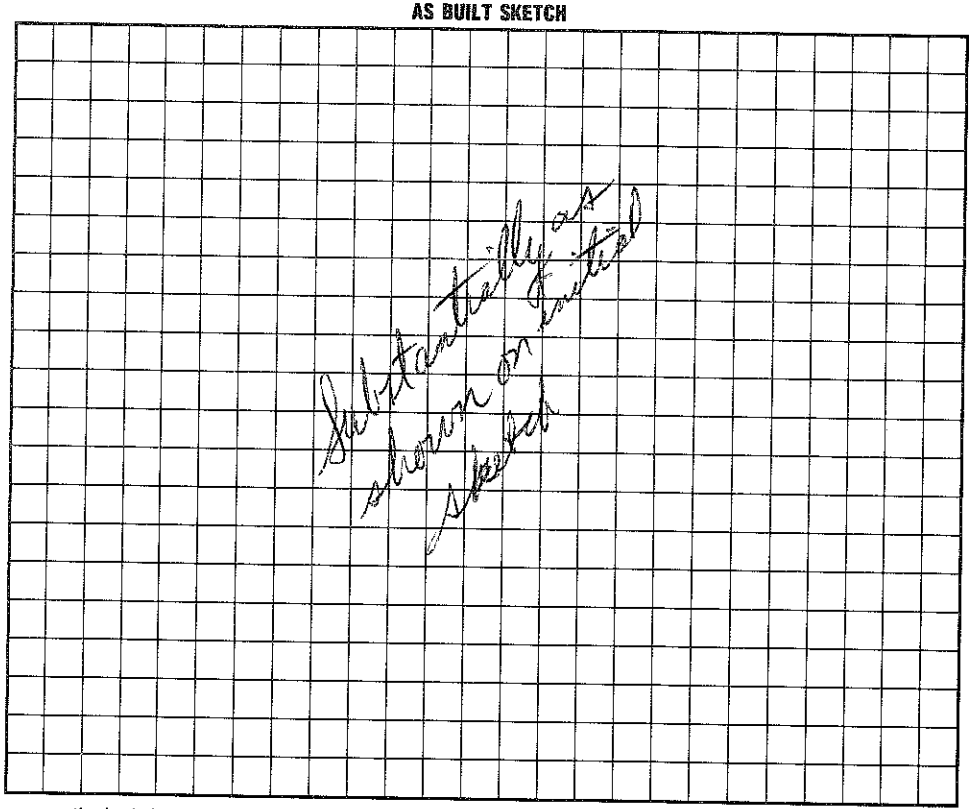

I understand that this permit can be suspended or revoked if any false information is supplied toward securing the permit/any unauthorized changes are made to the site/any unauthorized changes are made in the installation of the system. Improvement Permit is valid for 60 months from date of issuance.

Signed: _____

Improvement Permit by: David L. Hinson, RS date 5/31/94

Existing System Inspection by: _____ date _____

Installed by: Larry Beam

Certificate of Completion by: _____ date _____

Operation Permit by: David L. Hinson date 6/23/94

HEALTH DEPT. COPY: WHITE INSPECTION COPY (FINAL): GREEN OWNER COPY (FINAL): YELLOW INSPECTION COPY (INITIAL): PINK OWNER COPY (INITIAL): GOLD