IREDELL COUNTY HEALTH DEPARTMENT

STATESVILLE 704-878-5305 MOORESVILLE 704-664-5281

IMPROVEMENT PERMIT / CERTIFICATE OF COMPLETION / OPERATION PERMIT / EXISTING SYSTEM INSPE

PROPERTY DESCRIPTION NO. 15579 DATE July 29, 93 TAX MAP NO. 2G23A37

OWNER OR CONTRACTOR MI Homes PHONE: Business 4635-19-8024 Home

ADDRESS 1043 E. Morehead, Suite 105 Charlotte 28204

LOCATION 1100 TR Waterfoed at end on left

SUBDIVISION Pine Isle BLOCK / SECTION LOT 37 LOT AREA 20,000 ft²+ SITE CLASS. PS L.T.A.R. .3

Water Supply: ☐ Individual ☑ Community ☐ Public

Septic Tank: 1500 Gallons; STB 780 Date 4-20-93

Pump Tank: Gallons; PT Date

Nitrification Field: No. Fields 1 Square Feet Linear Feet 270

No Lines 4 Trench Width 24" Trench Depth Gravel Depth NA

☑ New System ☐ Repair System Type: I, II, III, IV, V, VI

System Description: gravity PPBPS

Repair System Description: grav./LP PPBPS

Maintenance Agreement Required: ☐ Yes ☑ No

☑ House/Mod. Home No. Bedrooms 4

☐ Mobile Home No. Bathrooms 3½

☐ Business No. Employees

☐ Other

☐ Slab ☑ Crawl Space ☐ Basement w/plumbing ☐ Basement wo/plumbing

Garbage Disposal: ☑ Yes ☐ No


Auto. Dishwasher: ☑ Yes ☐ No

Auto. Washing Machine: ☑ Yes ☐ No

Other

Comments Deck Not constructed at time of septic completion

INITIAL SITE SKETCH

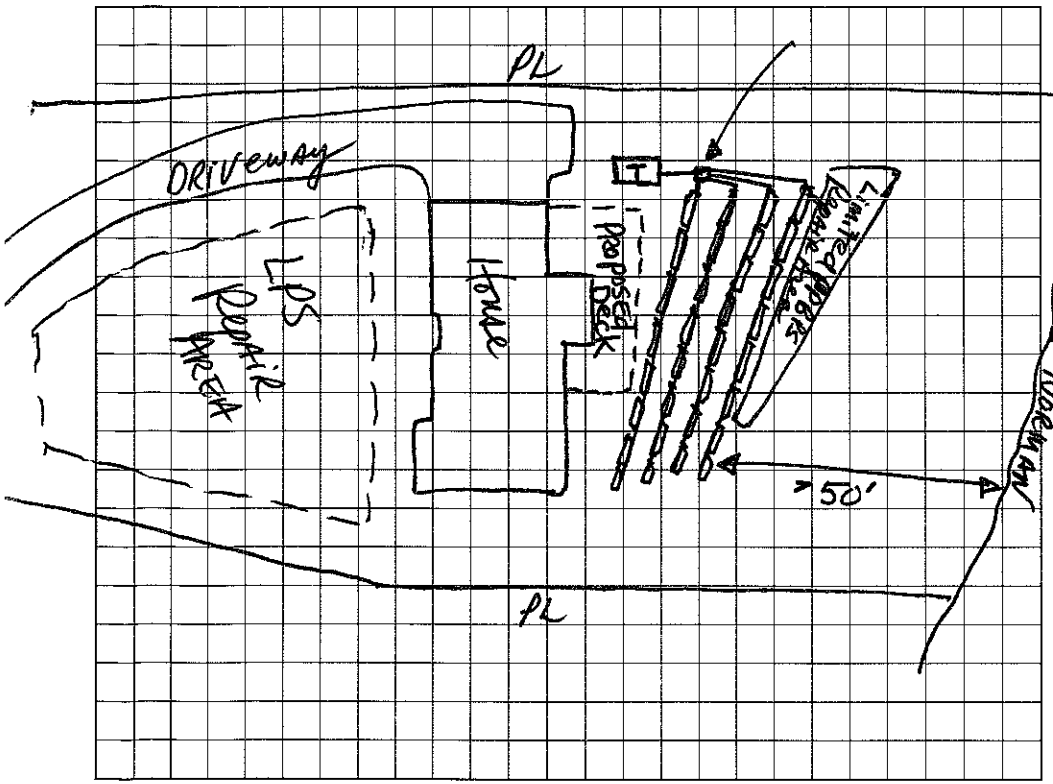

AS BUILT SKETCH

I understand that this permit can be suspended or revoked if any false information is supplied toward securing the permit/any unauthorized changes are made to the site/any unauthorized changes are made in the installation of the system. Improvement Permit is valid for 60 months from date of issuance.

Signed:

Improvement Permit by: date

Existing System Inspection by: date

Installed by:

Certificate of Completion by: date

Operation Permit by: Jane R Hamon date 7-29-93

HEALTH DEPT. COPY: WHITE INSPECTION COPY (FINAL): GREEN OWNER COPY (FINAL): YELLOW INSPECTION COPY (INITIAL): PINK OWNER COPY (INITIAL): GOLD