IREDELL COUNTY HEALTH DEPARTMENT

Statesville Office (704) 878-5305 Mooresville Office (704) 660-3625 PERMIT # Z13337

IMPROVEMENT PERMIT / AUTHORIZATION TO CONSTRUCT / OPERATION PERMIT / EXISTING SYSTEM

PIN # 4635-22-0865

APPLICANT: REED SAPP APPLICANT ADDRESS: 104 WATERHOUSE CT.

SITE ADDRESS: SAME PHONE: 980-721-0547 ALT. PHONE:

SITE DIRECTIONS: BSR, TRAFFIC CIRCLE, POINT DR., TR MEETING HOUSE, TL VINYARD, TL FALMOTH, TL WATERHOUSE

SUBDIVISION: THE POINT SECTION: 1A LOT # 27 LOT AREA: .99AC DESIGN FLOW: 480 L.T.A.R.: .3

Septic Tank 1500 (gal) STB 444 Date 1-20-14
Pump Tank (gal) PT Date
Pump Make Model Serial #
Nitrification Fields # Lines EXISTING Linear Ft:
Trench Width Max. Trench Bottom Depth Gravel Depth

☐ New System ☐ Repair ☐ Expansion System Type: I II ☒ III IV V VI
System Description: 25% REDUCTION
Repair System Description: PANEL BLOCK
Maintenance Agreement Required: ☐ YES ☒ NO
☒ GRAVITY ☐ PRESSURE

☐ Residence No. Bedrooms 4
☐ Business No. Persons
☒ Other POOL No. Employees
☐ Slab ☒ Crawl Space
☐ Basement w/plumbing ☐ Basement w/o plumbing

Water Supply: ☐ Private ☐ Public ☒ Community

Comments / Conditions:

INITIAL SITE SKETCH

SEE PLAN FROM PENNINGER SOIL CONSULTING PLLC.

AS BUILT SKETCH

Permit can be suspended or revoked if any false information is supplied toward securing the permit / any unauthorized changes are made to the site / any unauthorized changes are made in the installation of the system. **CONTACT A LOCATOR SERVICE PRIOR TO ANY EXCAVATION**

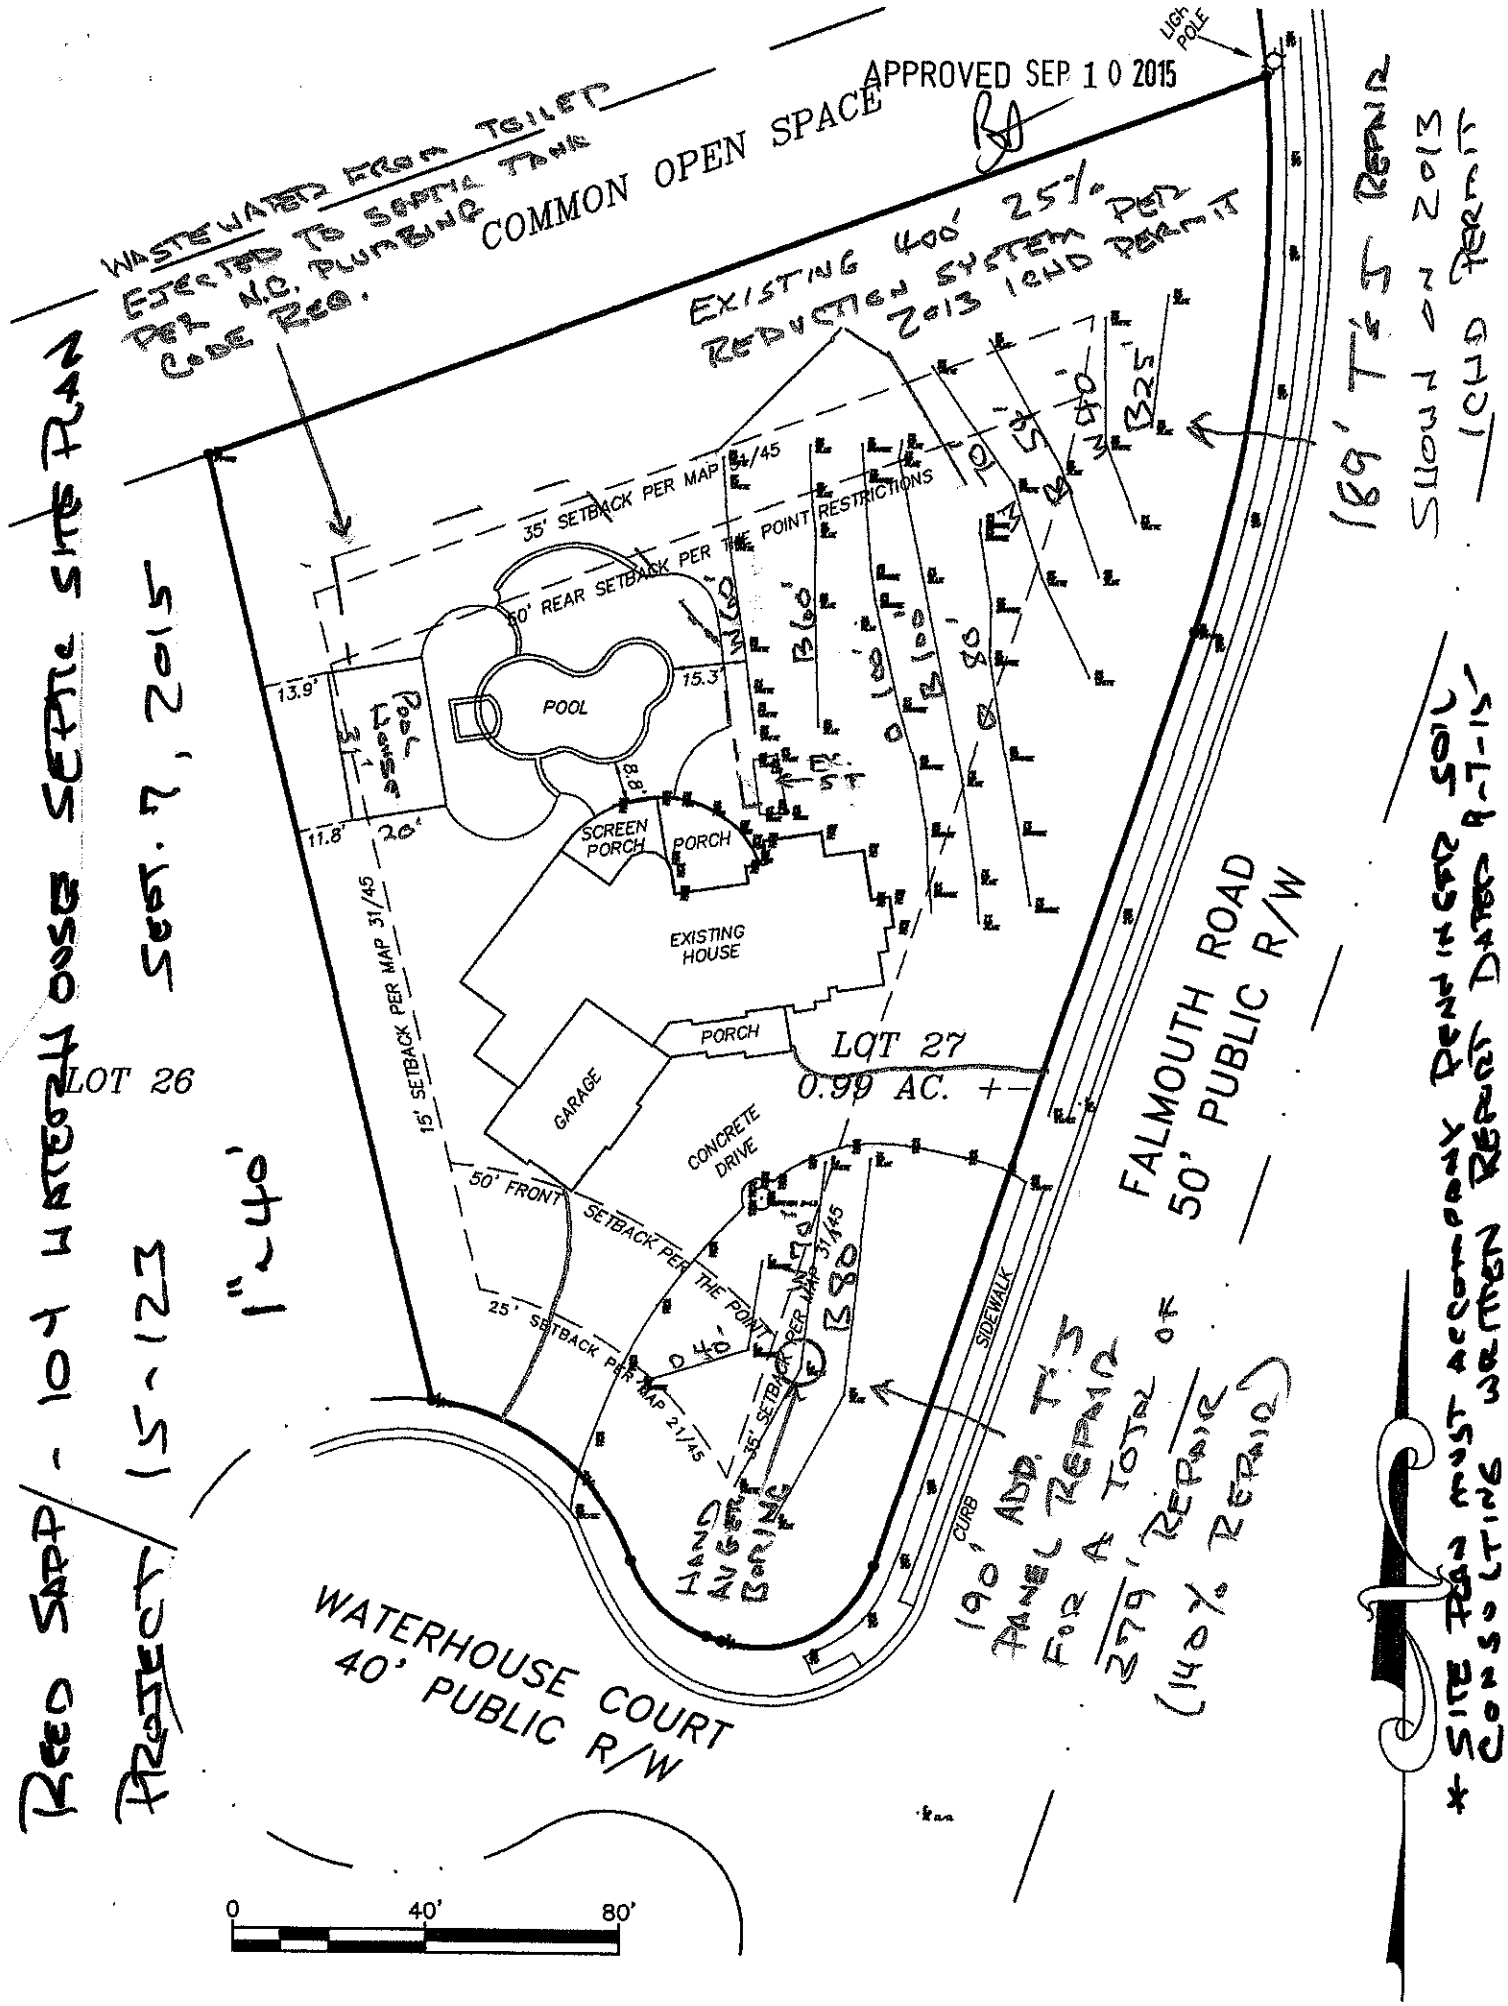
☐ **IMPROVEMENT PERMIT** *with plat valid without expiration* ☐ **IMPROVEMENT PERMIT** *with site plan valid for 60 mos.* ☐ **AUTHORIZATION TO CONSTRUCT** *valid for period equal to IMPROVEMENT PERMIT--not to exceed 60 mo.*

Owner / Applicant Signature: Date: 9/21/15 Installed by:

IMPROVEMENT PERMIT by: Date: OPERATION PERMIT by: Date:

AUTHORIZATION TO CONSTRUCT by: Date: Existing System Inspected by: APPROVED Date SEP 10 2015

Health Dept. Copy - WHITE Applicant (Final Approval) - YELLOW Applicant (Conditional Approval) - PINK


APPROVED SEP 10 2015
WASTEWATER FROM TOILET EJECTED TO SEPTIC TANK PER N.C. PLUMBING CODE REQ.
COMMON OPEN SPACE
EXISTING 400' 25% REDUCTION SYSTEM PER 2013 IHD PERMIT
LIGHT POLE
35' SETBACK PER MAP 31/45
50' REAR SETBACK PER THE POINT RESTRICTIONS
POOL
13.9'
15.3'
11.8'
20'
SCREEN PORCH
PORCH
EXISTING HOUSE
PORCH
GARAGE
CONCRETE DRIVE
15' SETBACK PER MAP 31/45
50' FRONT SETBACK PER THE POINT
25' SETBACK PER MAP 21/45
35' SETBACK PER MAP 31/45
LOT 26
LOT 27
0.99 AC. +-
FALMOUTH ROAD
50' PUBLIC R/W
SIDEWALK
CURB
WATERHOUSE COURT
40' PUBLIC R/W
190' ADD. T.H. PANEL REPAIR
FOR A TOTAL OF 279' REPAIR (140% REPAIR)
0
40'
80'
REED SARP - 104 WATERHOUSE CT. SEPTIC SITE PLAN
PROJECT 15-123
SEPT. 7, 2015
1" = 40'
