# IREDELL COUNTY HEALTH DEPARTMENT

STATESVILLE 704-878-5305 — MOORESVILLE 704-664-5281

## IMPROVEMENT PERMIT / AUTHORIZATION TO CONSTRUCT / OPERATION PERMIT / EXISTING SYSTEM INSPECTION

PERMIT# 07905 PIN# 4625944684 4635-22-1454 DATE Dec 9, '98

OWNER OR CONTRACTOR Crescent Resources Inc // GM Helms Const Inc. PHONE: Business 875-3211 Home

ADDRESS PO Box 2697 Huntersville 28070-2697

LOCATION Brawley Sch Rd. TL The Point Dr. Queen Anne Circle to Vineyard Dr. to Falmouth Rd. on Right

SUBDIVISION The Point BLOCK / SECTION 1A LOT 89 LOT AREA 37,609 ft² SITE CLASS. RS DESIGN FLOW 480 gpd L.T.A.R. .3

Septic Tank: 1500+ Gallons; STB 797 Date 7/31/98
Pump Tank: 1000 Gallons; PT 27 Date 8/28/98
Pump Make: _____ Model _____ Serial No. _____
Nitrification Field: No Fields 1 Square Feet 1200 Linear Feet 400
No Lines 5@80' Trench Width 36" Max Trench Bottom Depth 36"

☑ New System ☐ Repair System Type: I, II, (III), IV, V, VI
System Description: pumped-pm-25% Red. // INNOVATIVE
Repair System Description: SAME
Maintenance Agreement Required: ☐ Yes ☑ No

☑ House/Mod. Home No. Bedrooms 4/4
☐ Mobile Home No. Bathrooms 4
☐ Business No. Employees
☐ Other


Water Supply: ☐ Individual ☑ Public ☐ Community

Gravel Depth N/A ☐ Slab ☑ Crawl Space ☐ Basement w/plumbing ☐ Basement wo/plumbing


Comments:/Conditions: * ONE INSPECTION PORT PER LATERAL.
This permit Replaces permit issued Aug 6, '98

Comments:/Conditions:

INITIAL SITE SKETCH 1"=50'

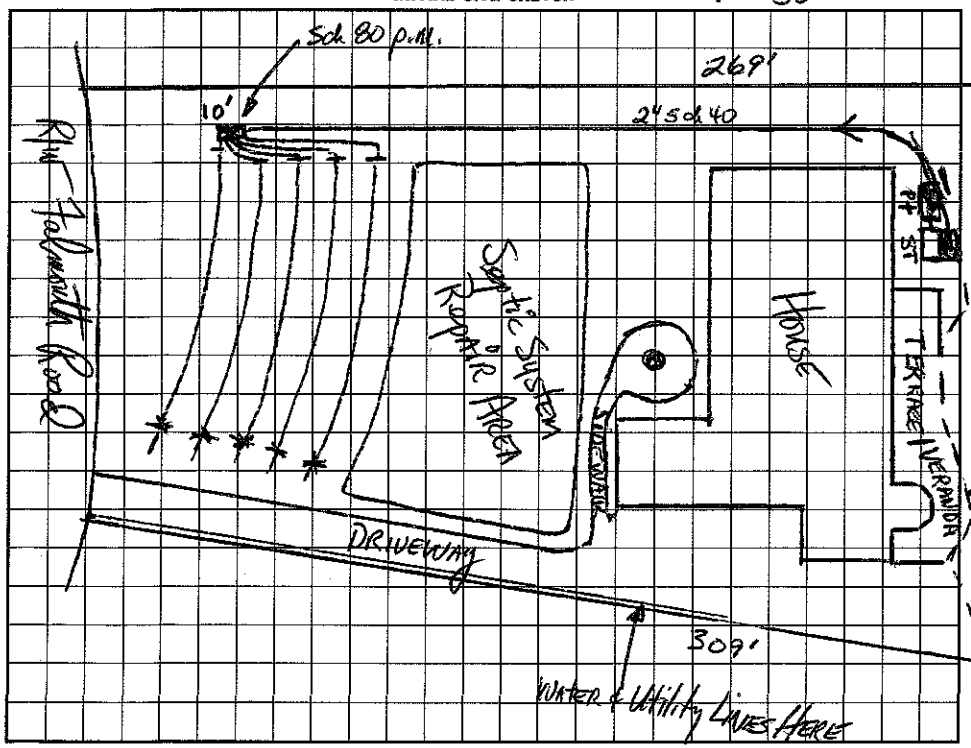


AS BUILT SKETCH

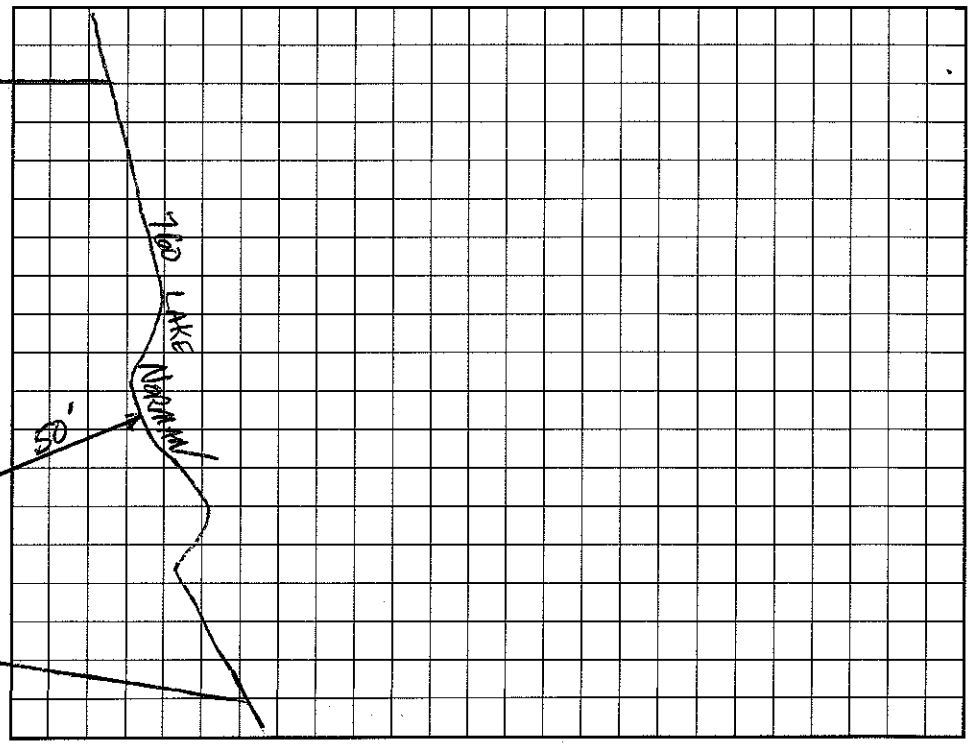


I understand that this permit can be suspended or revoked if any false information is supplied toward securing the permit/any unauthorized changes are made to the site/any unauthorized changes are made in the installation of the system. Improvement Permit with plat valid without expiration. Improvement Permit with site plan valid for sixty months. Authorization to Construct is valid for a period equal to that of Improvement Permit – not to exceed sixty months.

Signed: Carolyn Spellenberg date 12-14-98
Improvement Permit by: David R. Hamm, RS date 12-9-98
Authorization to Construct by: D R Hamm, RS date 12-9-98

Installed by: ~~R+R Contracting~~ R + H Inc.
Operation Permit by: Wesley Sparks RS date 3/17/00
Existing System Inspection by: _____ date _____

HEALTH DEPT. COPY: WHITE INSPECTION COPY (FINAL): GREEN OWNER COPY (FINAL): YELLOW INSPECTION COPY (INITIAL): PINK OWNER COPY (INITIAL): GOLD