IREDELL COUNTY HEALTH DEPARTMENT

STATESVILLE 704-878-5305 MOORESVILLE 704-664-5281

IMPROVEMENT PERMIT / AUTHORIZATION TO CONSTRUCT / OPERATION PERMIT / EXISTING SYSTEM INSPECTION

PERMIT # 158941 PIN # 4635222631 DATE 11-18-2009

OWNER or APPLICANT Ron Brown / Kingswood Homes PHONE: Business 704 889-1600 Home: 704 226-6766

OWNER or APPLICANT ADDRESS 106 Oakley Ave Pineville, NC 28134

LOCATION / DIRECTIONS Brawley School Rd TR Point Drive TL Meeting house TL Vineyard TL Falmouth on right

SUBDIVISION The Point BLOCK / SECTION ~~2~~ 1A LOT # 90-1 LOT AREA 1.38 Acres DESIGN FLOW 600gpd L.T.A.R. .25

Septic Tank 1500 Gallons: STB 389 Date 1-9-09

Pump Tank 1500 Gallons: PT 353 Date 5-1-09

Pump Make Zoeller Model E140 Serial #

Nitrification Field No Fields 1 No Lines 5 (6) Linear Feet 600'

Trench Width 36" Max. Trench Bottom Depth 36" Gravel Depth N/A

☒ New System ☐ Repair ☐ Expansion System Type I II (III) IV V VI

System Description: Pump-Pm-25% Reduction

Repair System Description: Pump UP - Panel (480)

Maintenance Agreement Required ☐ YES ☒ NO

☒ GRAVITY ☒ PRESSURE


☒ Residence No. Bedrooms 5 ☐ Business No. Persons ☐ Other No. Employees ☐ Slab ☒ Crawl Space ☐ Basement w/plumbing ☐ Basement w/o plumbing

Water Supply: ☐ Private ☒ Public ☒ Community

Comments / Conditions

Scale 1:50 PL 260'

INITIAL SITE SKETCH

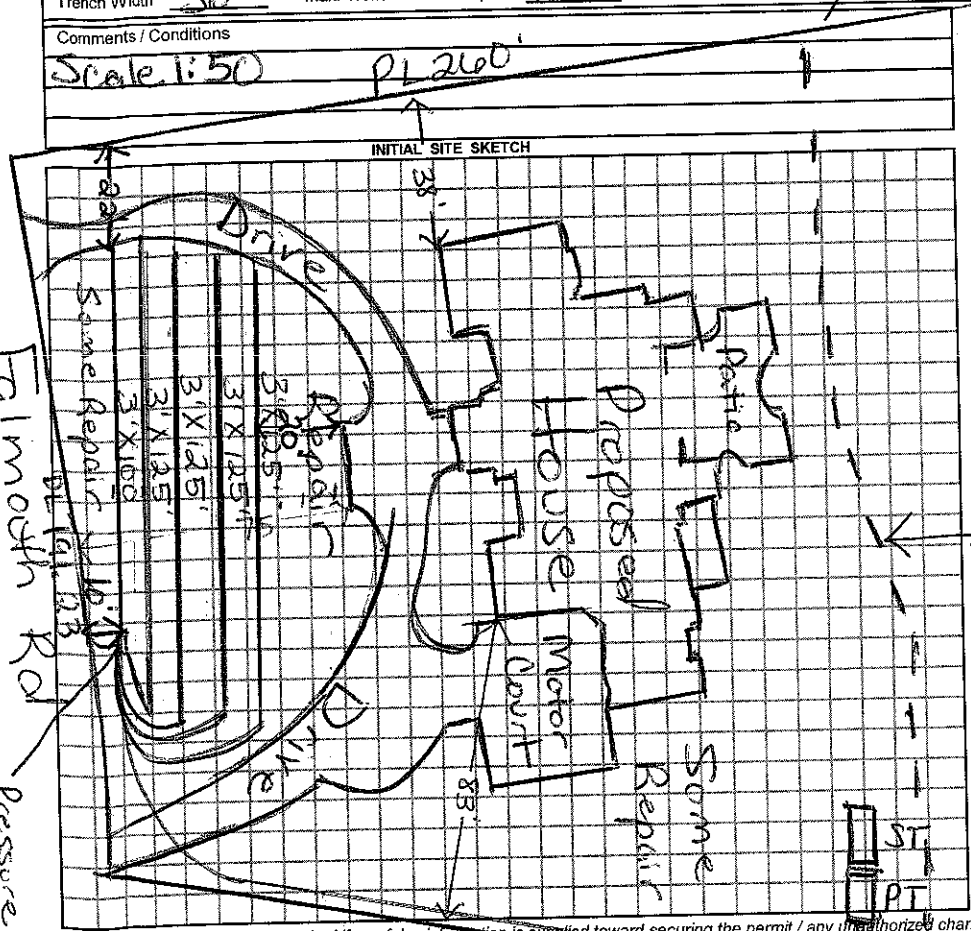

Comments / Conditions Notes: Use 1½" sch 80 tap for 100ft line & 1½" sch 40 tap for 125ft line. Must keep drive out of drain field area. This permit replaces previous permits.

AS BUILT SKETCH

Supply line N 6° off PL up to Motor Ct.

Checked tanks 5/28/10

Checked lines 6/2/10 & 6/3/10

6 lines DD 100'

Lake Norman

Permit can be suspended or revoked if any false information is supplied toward securing the permit / any unauthorized changes are made to the site / any unauthorized changes are made in the installation of the system.

☐ *IMPROVEMENT PERMIT w / plat valid without expiration* ☒ *IMPROVEMENT PERMIT w / site plan valid for 60 mos.*

☐ *AUTHORIZATION TO CONSTRUCT valid for period equal to IMPROVEMENT PERMIT-not to exceed 60 mo.*

Owner / Applicant Signature: Date 11-19-09

Improvement Permit by: Date 11/18/09

Authorization to Construct by: Date 11/18/09

Installed by: Specialty Septic RE-113 Date: 9/24/20

Operation Permit by: Date:

Existing System Inspected by: Date:

U SHOULD CONTACT A LOCATOR SERVICE PRIOR TO ANY EXCAVATION.

WHITE COPY Environmental Health YELLOW COPY (Final) Owner / Applicant PINK COPY (Initial) Owner / Applicant