IREDELL COUNTY HEALTH DEPARTMENT

STATESVILLE 704-878-5305 MOORESVILLE 704-664-5281

IMPROVEMENT PERMIT / AUTHORIZATION TO CONSTRUCT / OPERATION PERMIT / EXISTING SYSTEM INSPECTION

PERMIT# 111367 PIN# 4635222668 4635223823 ✓ DATE 5-10-04

OWNER OR CONTRACTOR Whitley Construction PHONE: Business 658-9215 Home Cliff Makee 400-6071

ADDRESS 132 Cedar Bluff Mooresville NC 28117

LOCATION Brawley School Road to Point Dr TL Meeting House TL Easton TL Old Post TL Falmouth

SUBDIVISION Point BLOCK / SECTION A LOT 90-2 LOT AREA 1.59 Acres SITE CLASS. PS DESIGN FLOW 600gpd L.T.A.R. .3

Septic Tank: 1500 Gallons; STB 338 Date 12-11-04

Pump Tank: 1500 Gallons; PT 477 Date 12-12-04

Pump Make: Goulds Model WE0312M Serial No.

Nitrification Field: No Fields 1 Square Feet 1500 Linear Feet 500

No Lines 4@125' Trench Width 36" Max Trench Bottom Depth 36" Gravel Depth N/A

☒ New System ☐ Repair System Type: I, II, (III), IV, V, VI

System Description: Pump (PM) 25% Reduction

Repair System Description: Pump-LP-Panel Blk

Maintenance Agreement Required: ☐ Yes ☒ No

☒ House/Mod. Home ☐ Mobile Home ☐ Business ☐ Other

No. Bedrooms 5 No. Bathrooms 5½ No. Employees

☐ Slab ☒ Crawl Space ☐ Basement w/plumbing ☐ Basement wo/plumbing


Water Supply: ☐ Individual ☐ Public ☒ Community

Comments:/Conditions:

Scale = 1:50

PL 318

INITIAL SITE SKETCH

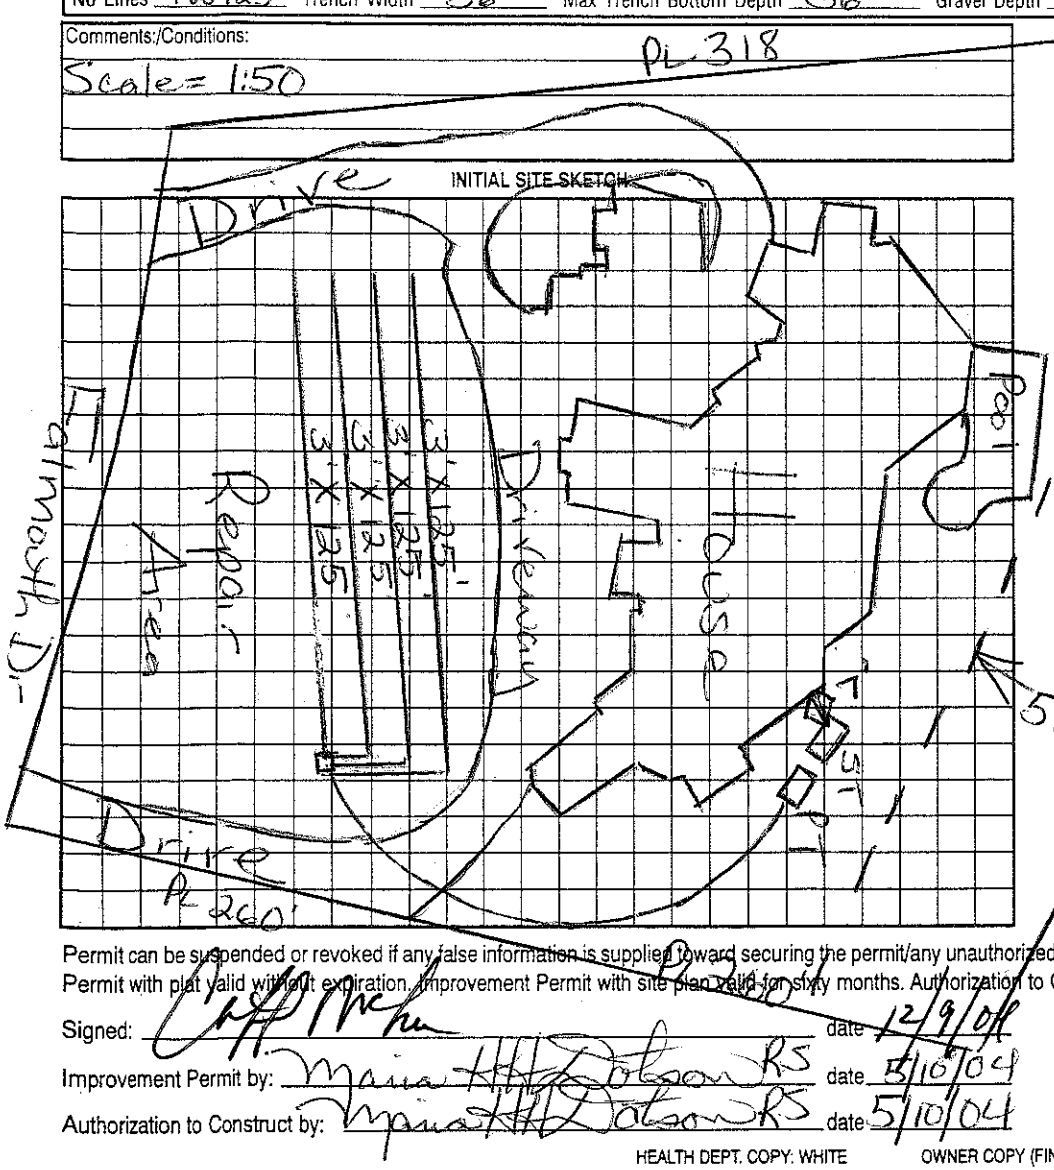

Comments:/Conditions:

1-18-05 Ok to move initial Drainfield closer to road & put repair area closer to house. 2m Pressure checked 2/2/05

AS BUILT SKETCH

Installed 4" Plastic Chamber for Drainfield

Lake Norman

Permit can be suspended or revoked if any false information is supplied toward securing the permit/any unauthorized changes are made to the site/any unauthorized changes are made in the installation of the system. Improvement Permit with plat valid without expiration. Improvement Permit with site plan valid for sixty months. Authorization to Construct is valid for a period equal to that of Improvement Permit – not to exceed sixty months.

Signed: [signature] date 12/9/04

Improvement Permit by: Maria H. Dotson RS date 5/10/04

Authorization to Construct by: Maria H. Dotson RS date 5/10/04

Installed by: Curt Dunning RS

Operation Permit by: Maria H. Dotson date 4/6/05

Existing System Inspection by: date

HEALTH DEPT. COPY: WHITE OWNER COPY (FINAL): YELLOW OWNER COPY (INITIAL): PINK