IREDELL COUNTY HEALTH DEPARTMENT

Statesville Office (704) 878-5305 Mooresville Office (704) 660-3625 PERMIT # 210226

IMPROVEMENT PERMIT / AUTHORIZATION TO CONSTRUCT / OPERATION PERMIT / EXISTING SYSTEM

PIN # 4635223823

APPLICANT: Augusta Homes / Alan Levine APPLICANT ADDRESS: 10602 Bailey Rd Ste B Cornelius, NC

SITE ADDRESS: 145 Falmouth Mooresville, NC PHONE: 7042014460 ALT. PHONE: 704 892 7795

SITE DIRECTIONS: Brawley School Rd to traffic circle, TR Meeting House, TL Vineyard, TL Falmouth on right

SUBDIVISION: The Point SECTION: 1-A LOT # 90-2 LOT AREA: 1.59 Ac DESIGN FLOW: 600gpd L.T.A.R.: 1.3

Existing


Septic Tank 1500 (gal)	STB	Date	☐ New System ☑ Repair ☐ Expansion System Type: I II III IV V VI	☒ Residence	No. Bedrooms 5
Pump Tank 1500 (gal)	PT	Date	System Description: Exist PM-25% Reduction	☐ Business	No. Persons 10
Pump Make	Model	Serial #	Repair System Description: Pump-LP Panel Blk	☐ Other	No. Employees
# Nitrification Fields 1	# Lines 4	Linear Ft: 500	Maintenance Agreement Required: ☐ YES ☒ NO	☐ Slab	☐ Crawl Space
Trench Width 36"	Max. Trench Bottom Depth 36"	Gravel Depth N/A	☐ GRAVITY ☒ PRESSURE	☐ Basement w/plumbing	☐ Basement w/o plumbing

Water Supply: ☐ Private ☐ Public ☐ Community

Comments / Conditions:


Scale 1:50 PL 318

INITIAL SITE SKETCH

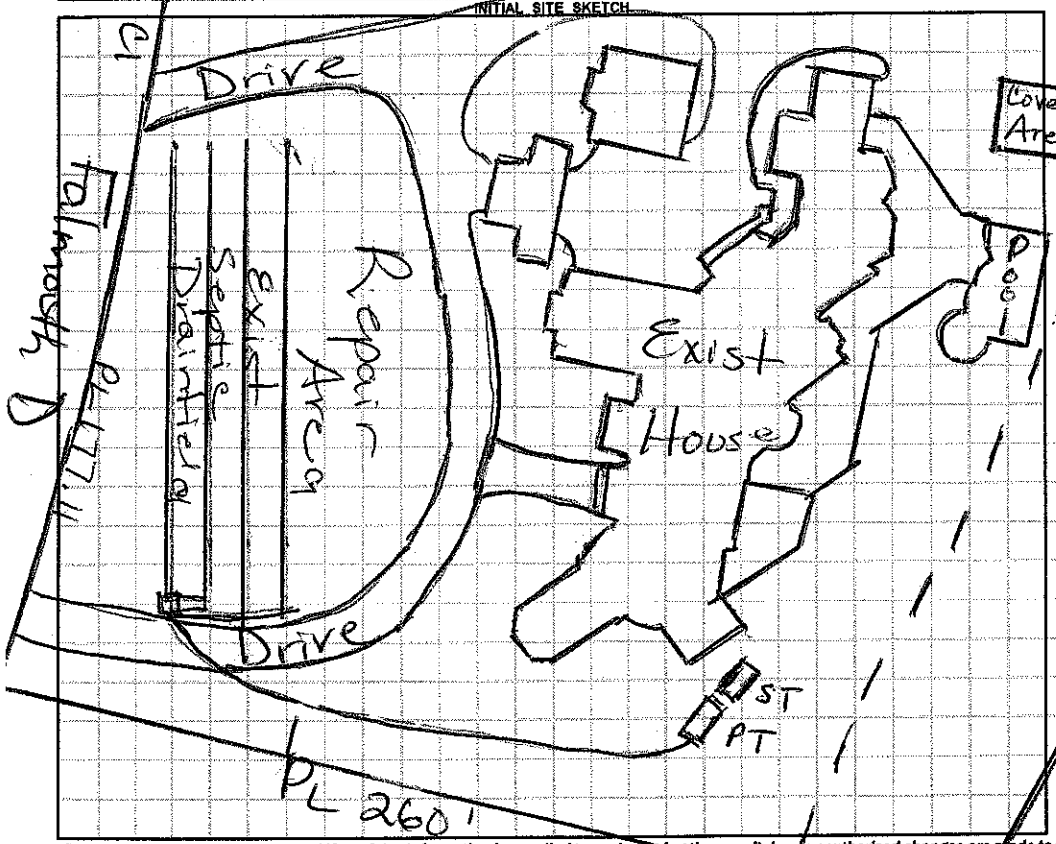

AS BUILT SKETCH

The proposed Outdoor Kitchen does not appear to impact the existing Septic System. Setbacks to Septic are ok

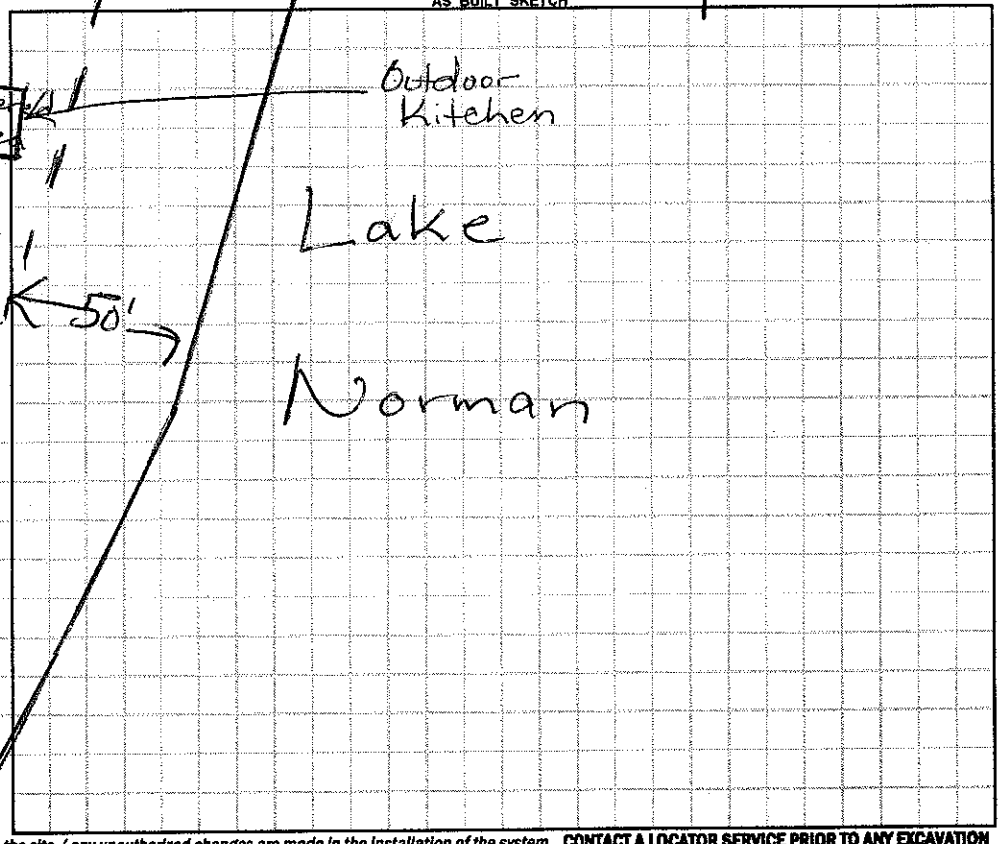

Permit can be suspended or revoked if any false information is supplied toward securing the permit / any unauthorized changes are made to the site / any unauthorized changes are made in the installation of the system. **CONTACT A LOCATOR SERVICE PRIOR TO ANY EXCAVATION**

☐ **IMPROVEMENT PERMIT** *with plat valid without expiration.* ☐ **IMPROVEMENT PERMIT** *with site plan valid for 60 mos.* ☐ **AUTHORIZATION TO CONSTRUCT** *valid for period equal to IMPROVEMENT PERMIT--not to exceed 60 mo.*

Owner / Applicant Signature: Shelly Mong Date: 6-10-15 Installed by:

IMPROVEMENT PERMIT by: Date: OPERATION PERMIT by: Date:

AUTHORIZATION TO CONSTRUCT by: Date: Existing System Inspected by: Marian H. Dotson RS Date: 6/10/15

Health Dept. Copy - WHITE Applicant (Final Approval) - YELLOW Applicant (Conditional Approval) - PINK