IREDELL COUNTY HEALTH DEPARTMENT

STATESVILLE 704-878-5305 MOORESVILLE 704-[illegible]-5281

IMPROVEMENT PERMIT / AUTHORIZATION TO CONSTRUCT / OPERATION PERMIT / EXISTING SYSTEM INSPECTION

PERMIT# 07/916 PIN# 4625944684 4635-23-1404 DATE Aug 10, '98

OWNER OR CONTRACTOR Crescent Resources Inc. // Simonini Builders PHONE: Business _____ Home _____

ADDRESS P.O. Box 1003, Charlotte

LOCATION Brawley Sch Rd. TL The Pointe DR. Queen Anne Circle to Vineyard Dr. to Falmouth Rd, on Right near Barnstable Ct.

SUBDIVISION The Pointe BLOCK / SECTION 1A LOT 96 LOT AREA 34,309 ft² SITE CLASS. PS DESIGN FLOW 480gpd L.T.A.R. .25-.3

Septic Tank: 1000/500 Gallons; STB 339 Date 2-29-00

Pump Tank: 1000 Gallons; PT 2-9 Date 3-4-00

Pump Make: _____ Model _____ Serial No. _____

Nitrification Field: No Fields 1 Square Feet 1350 Linear Feet 450

No Lines 5@90' Trench Width 36" Max Trench Bottom Depth 36" Gravel Depth N/A

☑ New System ☐ Repair System Type: I, II, III, IV, V, VI

System Description: pumped pm - 25% Reduction

Repair System Description: 1 LP Panel Block

Maintenance Agreement Required: ☐ Yes ☑ No initially

☑ House/Mod. Home ☐ Mobile Home ☐ Business ☐ Other

No. Bedrooms 4 No. Bathrooms 4 No. Employees _____


☐ Slab ☑ Crawl Space ☐ Basement w/plumbing ☐ Basement wo/plumbing

Water Supply: ☐ Individual ☑ Public ☑ Community


Comments:/Conditions: Remove old burns terraces.
X ONE INSPECTION/OBSERVATION PORT PER LATERAL.
7-22-99 Reviewed house & site plan - appears in compliance w/IP

Comments:/Conditions: Tanks & lines checked 4/14/2000 MA

INITIAL SITE SKETCH

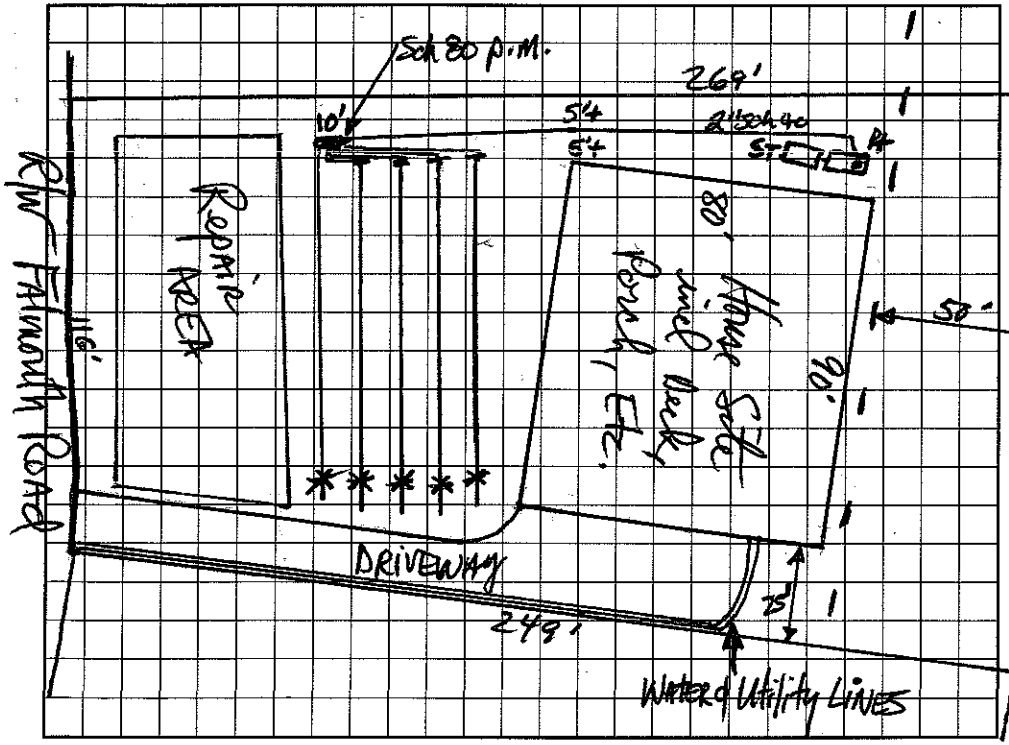

AS BUILT SKETCH

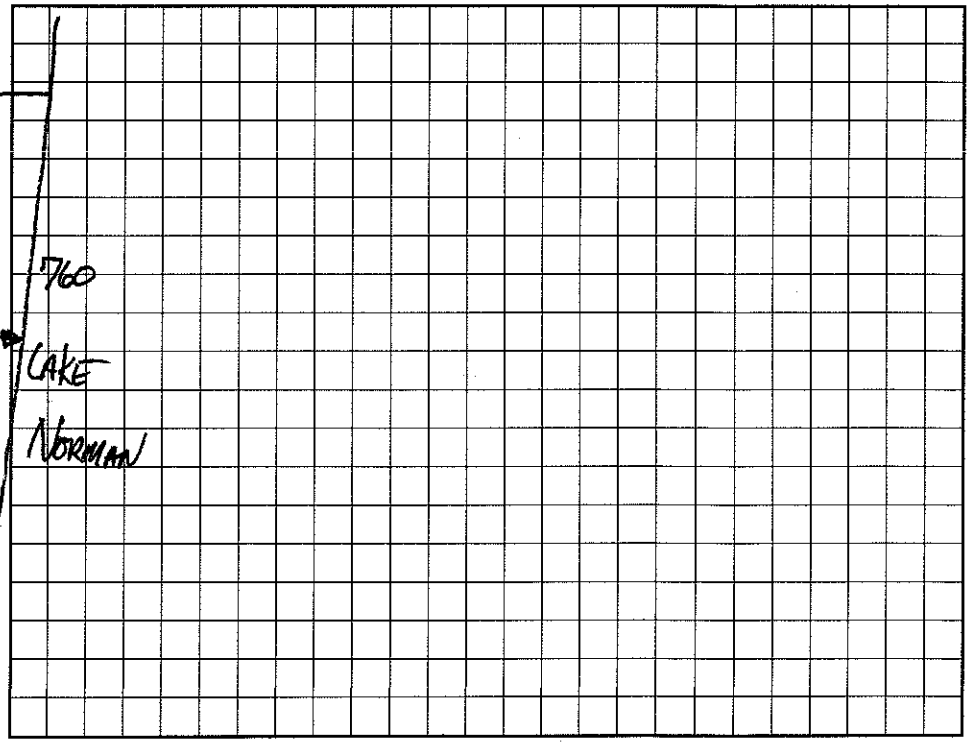

I understand that this permit can be suspended or revoked if any false information is supplied toward securing the permit/any unauthorized changes are made to the site/any unauthorized changes are made in the installation of the system. Improvement Permit with plat valid without expiration. Improvement Permit with site plan valid for sixty months. Authorization to Construct is valid for a period equal to that of Improvement Permit – not to exceed sixty months.

Signed: Paul G Pinyan date 8-20-98 Installed by: R & H Inc

Improvement Permit by: Wesley Sparks, RS date 8-10-98 Operation Permit by: Wesley Sparks RS. date 6/22/00

Authorization to Construct by: Wesley Sparks, RS date 7-22-99 Existing System Inspection by: _____ date _____

HEALTH DEPT. COPY: WHITE INSPECTION COPY (FINAL): GREEN OWNER COPY (FINAL): YELLOW INSPECTION COPY (INITIAL): PINK OWNER COPY (INITIAL): GOLD